

PLAT AND RECORD

149


Of a Survey on Section 19 T 4 R 10 E. of the 4 P. M. in Union Township
 Rock County, Wisconsin, made Nov. the 9th 1860

I hereby certify that the following is a correct record of said survey as made by me.

COUNTY BUILDING
 IN CITY OF БЕЛОIT

(Signed) Edward Ruger

County Surveyor.

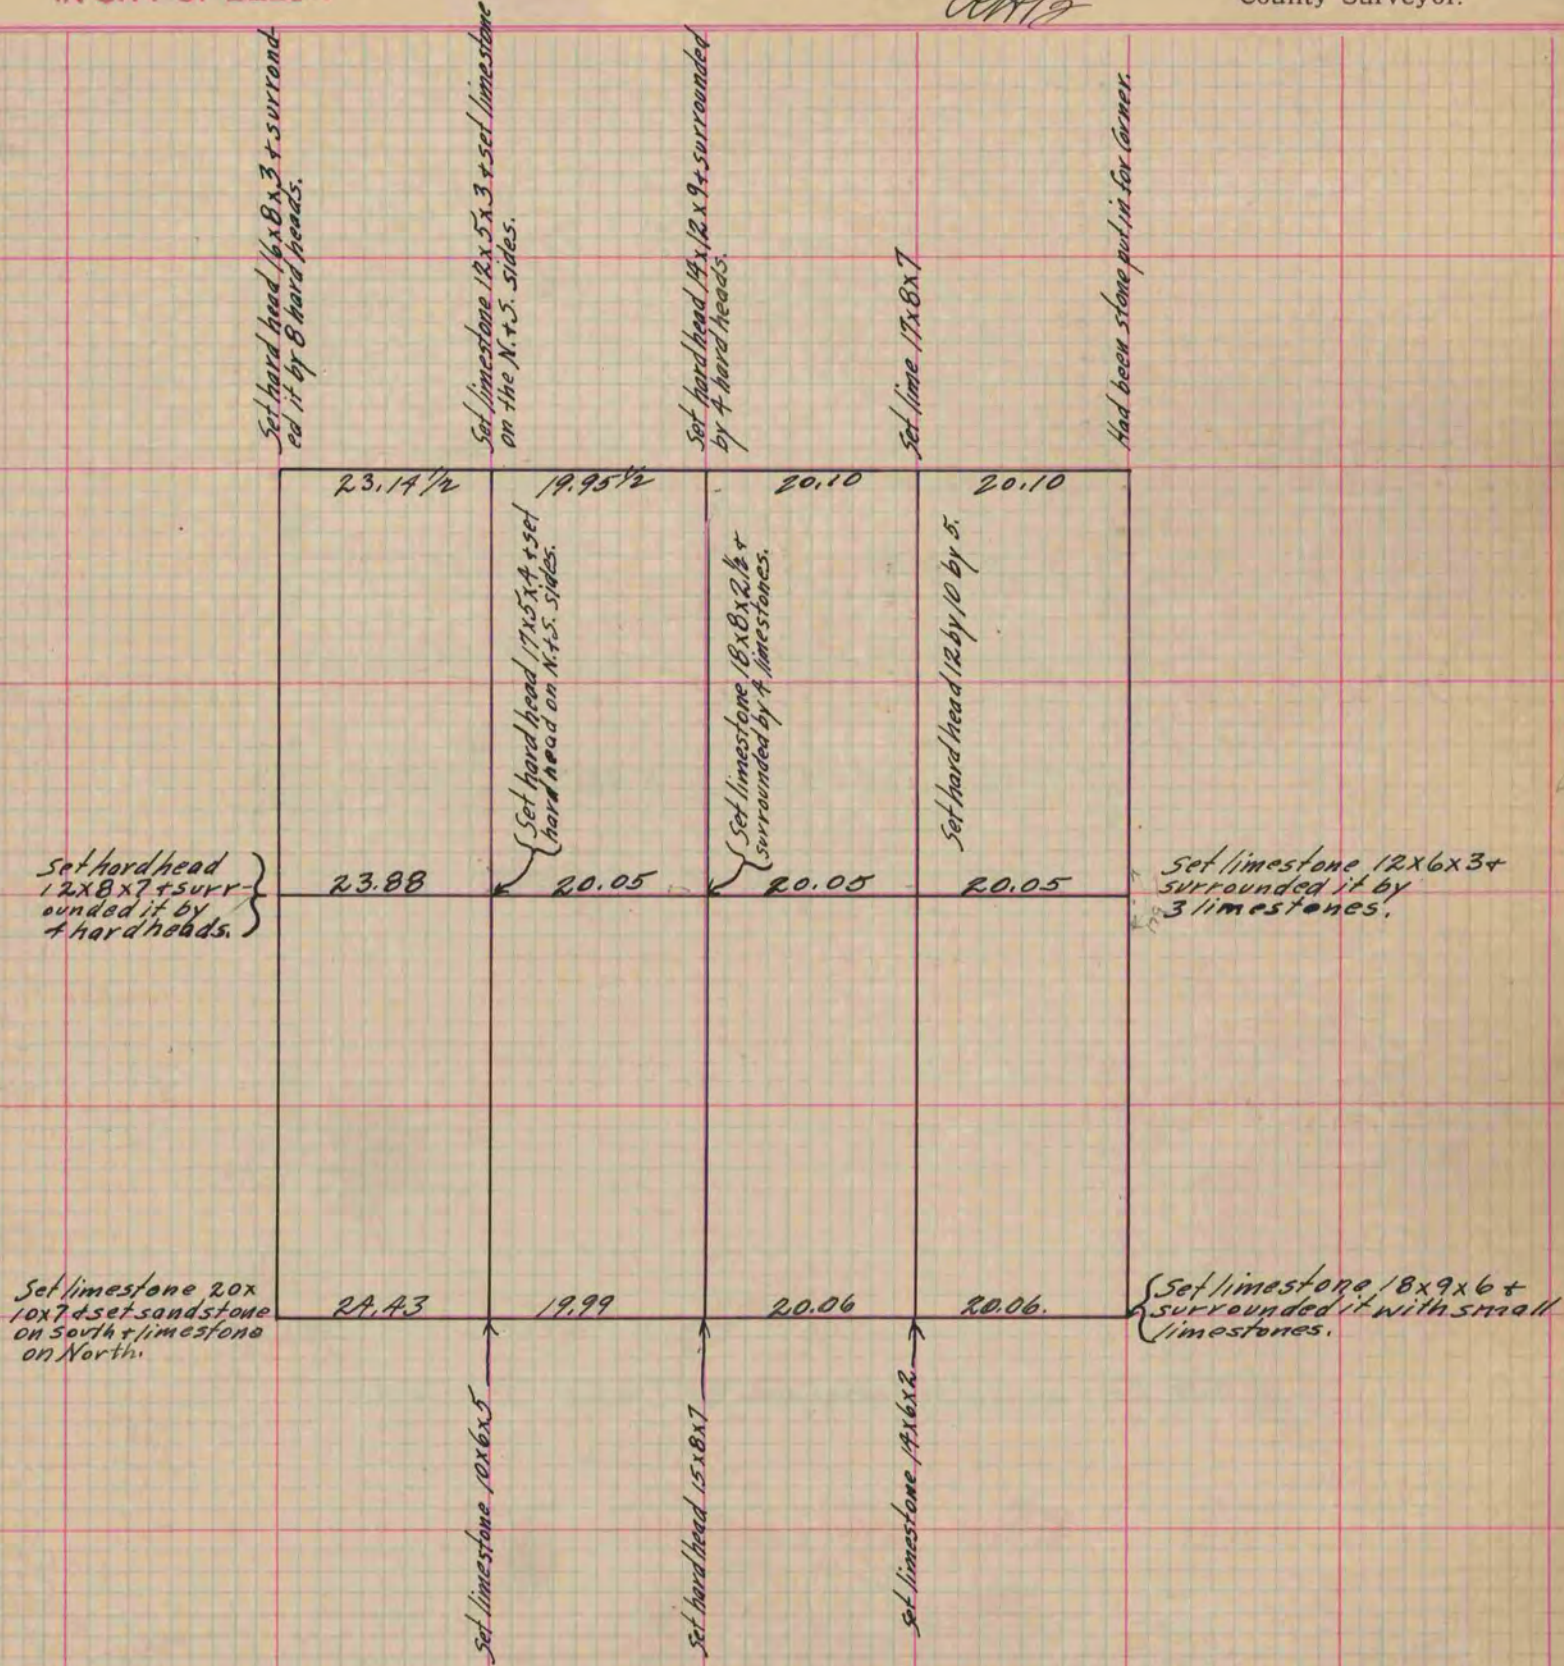

Copied from Page 158 Vol. 1. Original County Surveyors Record.