

PLAT AND RECORD

Of a Survey on Section 30 T 4 R 10 E. of the 4 P. M. in Union Township


Rock County, Wisconsin, made November the 7th & 8th 1860

I hereby certify that the following is a correct record of said survey as made by me.

COUNTY BUILDING
IN CITY OF БЕЛОIT

(Signed) Edward Ruger.

County Surveyor.

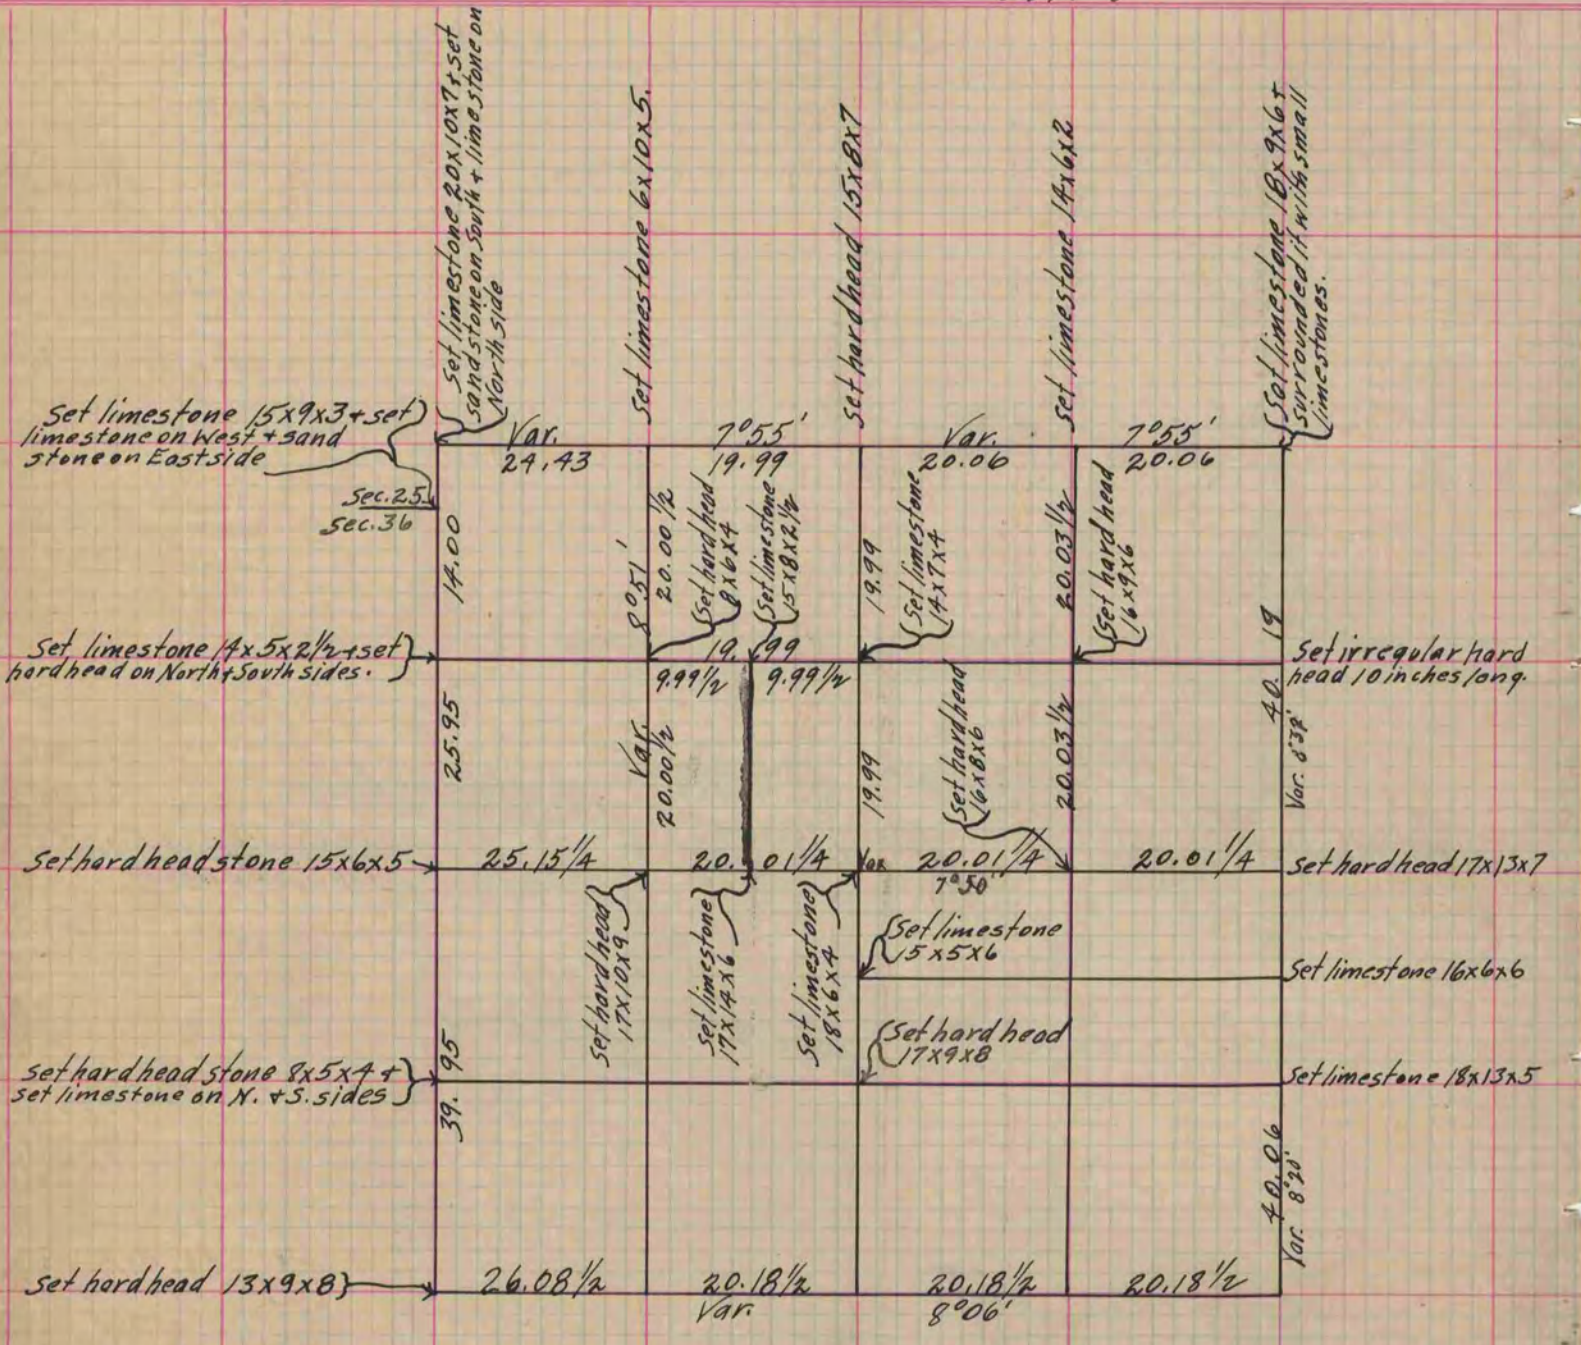

Copied from Page 157 Vol. 1. Original County Surveyor's Record.