

PLAT AND RECORD

Of a Survey on Section 4 T 4 R 14 E. of the 4 P. M. in Lima Township


Rock County, Wisconsin, made September the 21st 1860

I hereby certify that the following is a correct record of said survey as made by me.

COUNTY BUILDING
IN CITY OF БЕЛОIT

(Signed) Edward Ruger.
ERUG

County Surveyor.

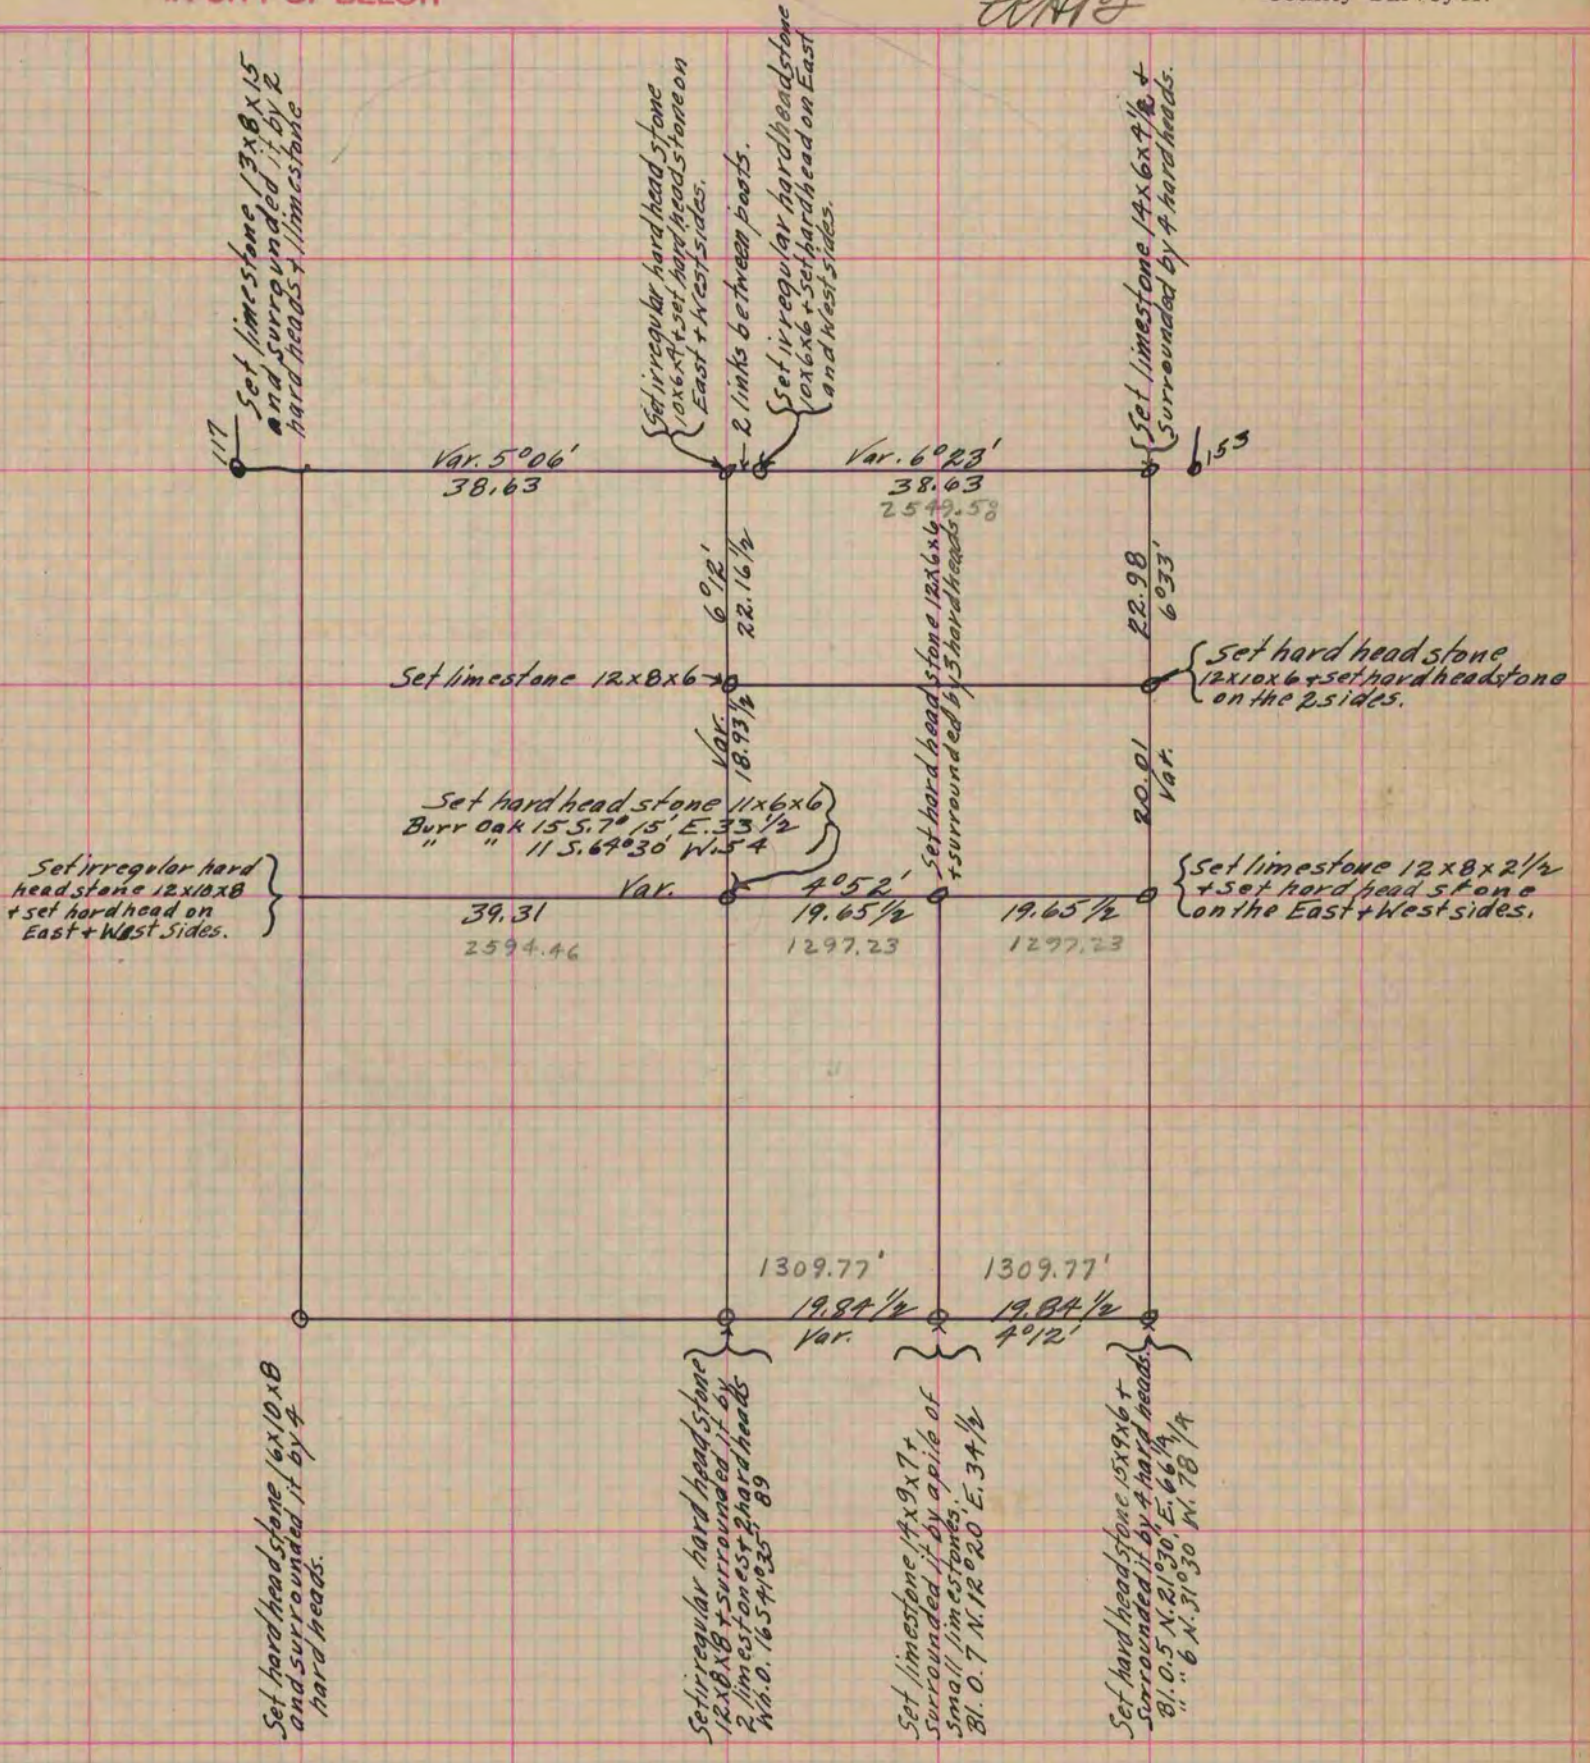

Copied from Page 148 Vol. 1. Original County Surveyors Record.