

PLAT AND RECORD

173


Of a Survey on Section 20 T 3 R 14 E. of the 4 P. M. in Johnstown Township
Rock County, Wisconsin, made _____ the _____ 19__

I hereby certify that the following is a correct record of said survey as made by me.

COUNTY BUILDING
IN CITY OF БЕЛОIT

(Signed) Edward Ruger
ERB

County Surveyor.

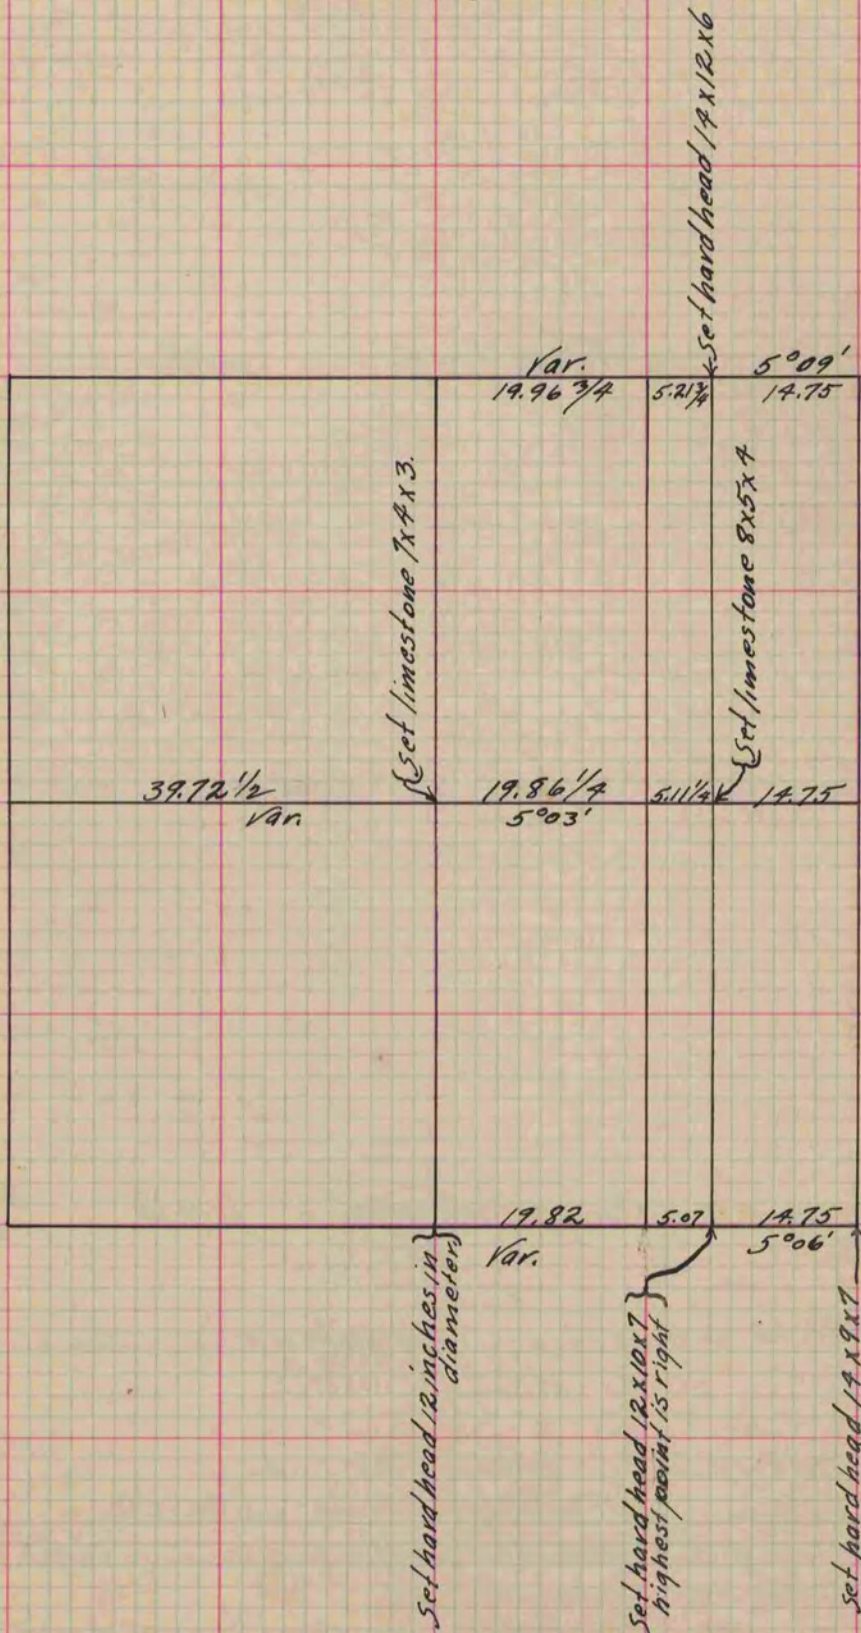

Copied from Page 182 Original County Surveyor's Record.