

# PLAT AND RECORD


Of a Survey on Section 18 T 4 R 10 E. of the 4 P. M. in Union Township  
Rock County, Wisconsin, made June the 4th 1861

I hereby certify that the following is a correct record of said survey as made by me.

COUNTY BUILDING  
IN CITY OF БЕЛОIT

(Signed) Edward Ruper

County Surveyor.

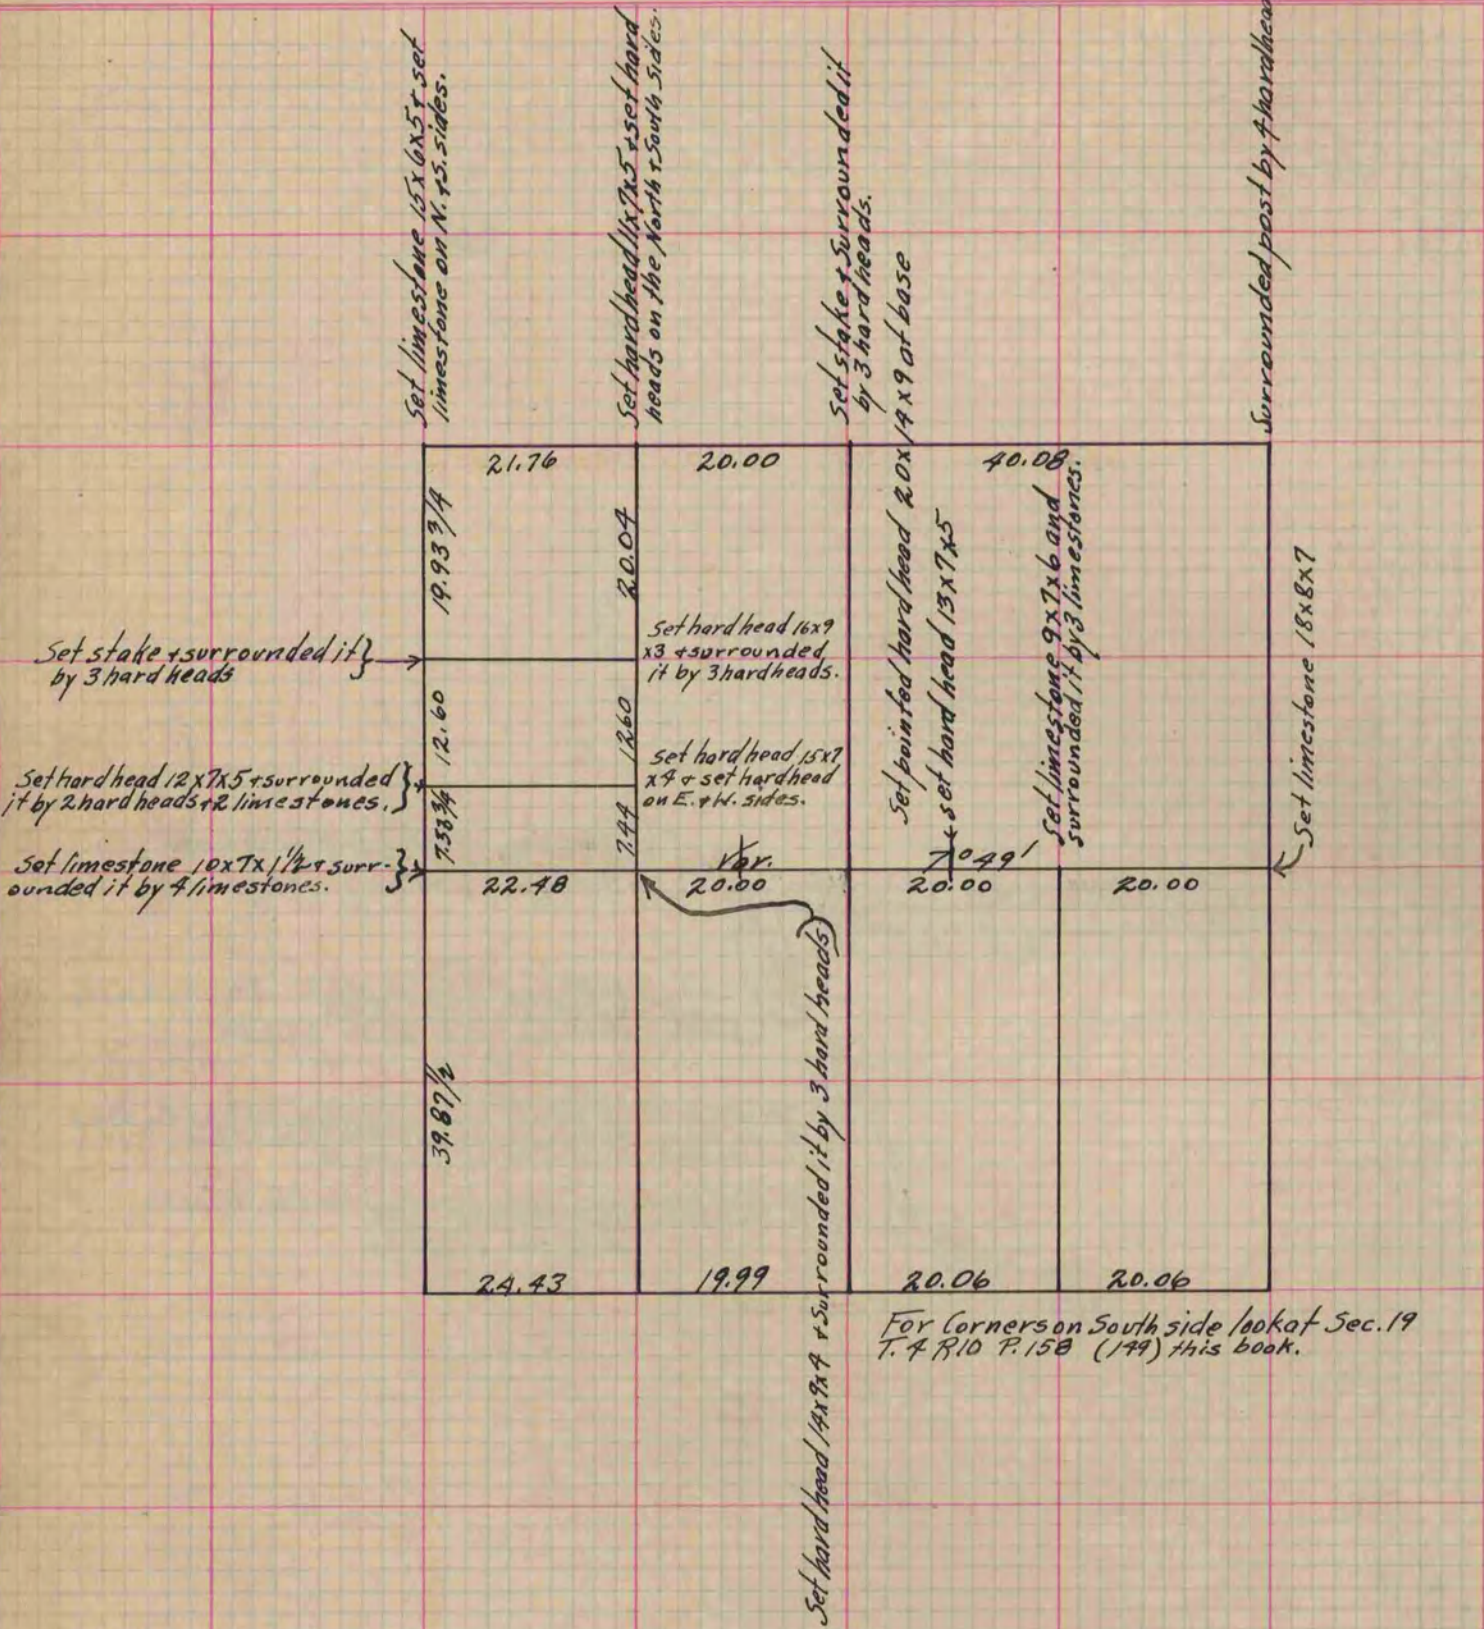

Copied from Page 175 Vol. One Original County Surveyor's Book.