

PLAT AND RECORD


COUNTY BUILDING
IN CITY OF BELOIT

Of a Survey on Section 8-17 T 3 R 12 E. of the 4 P. M. in Janesville Township

Rock County, Wisconsin, made August the 16th 1921

I hereby certify that the following is a correct record of said survey as made by me.

(Signed) Alex W. Ely
County Surveyor.

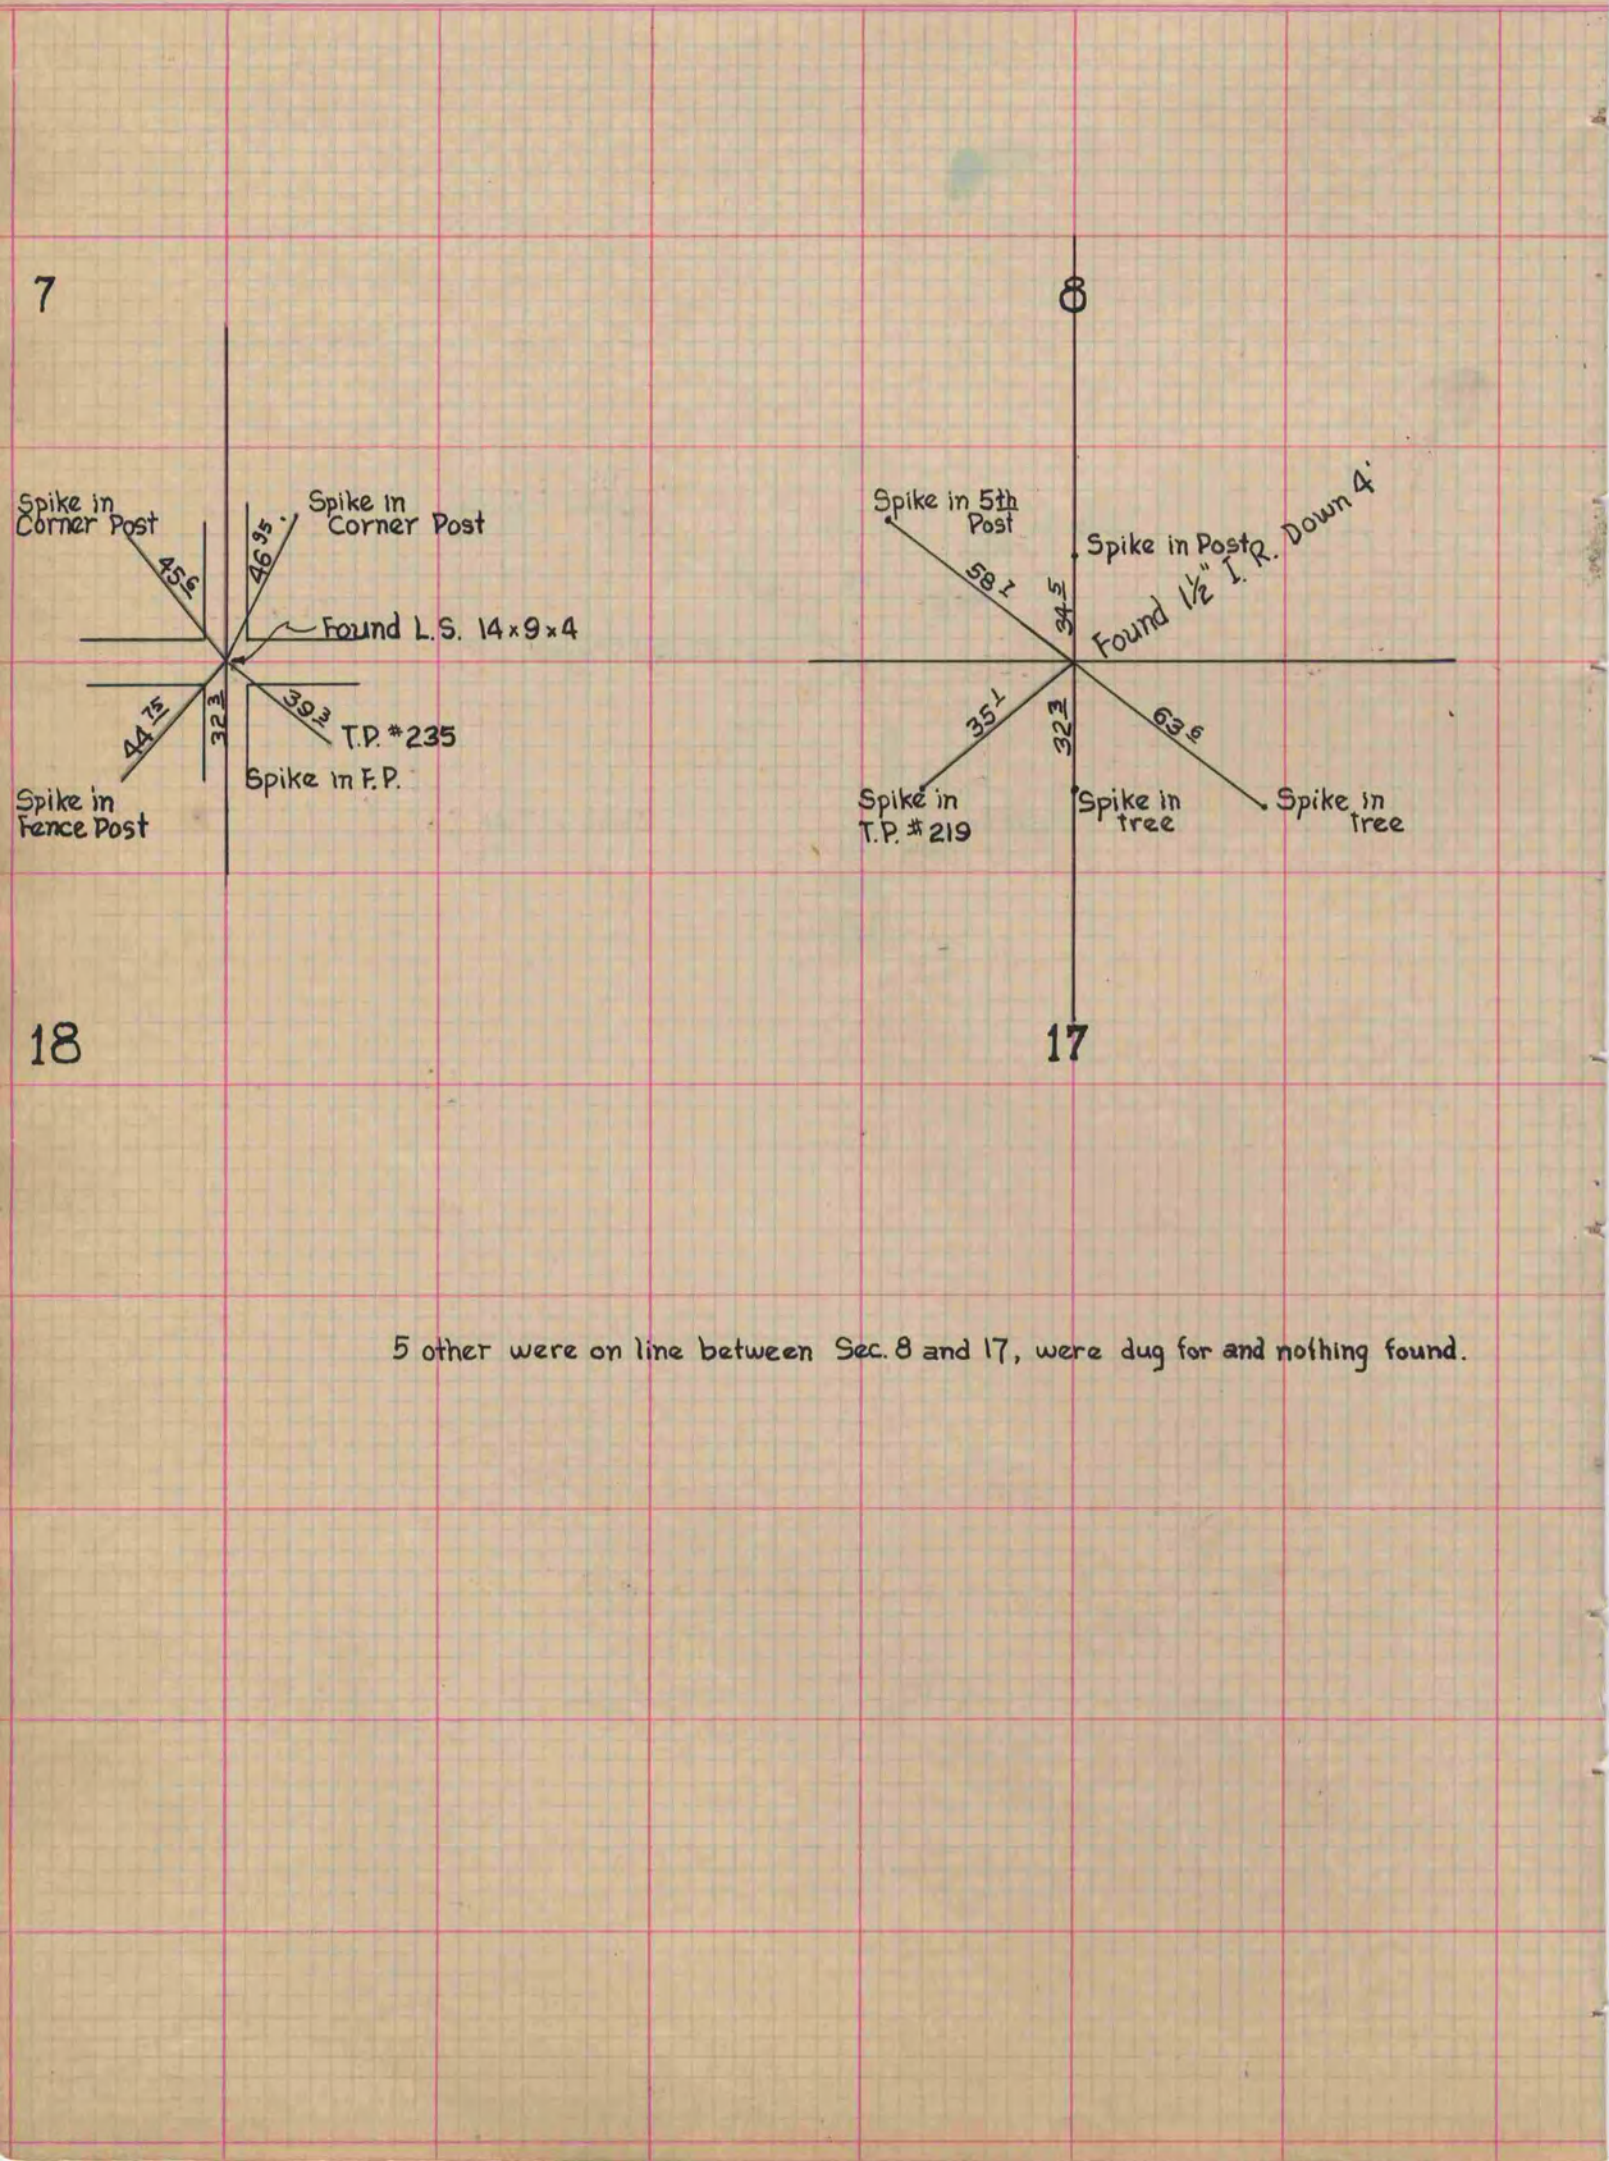

5 other were on line between Sec. 8 and 17, were dug for and nothing found.