

Of a Survey on Section 14 T 3 R 13 E. of the 4 P. M. in Harmony Township


Rock County, Wisconsin, made May the 6th 1861

I hereby certify that the following is a correct record of said survey as made by me.

COUNTY BUILDING  
IN CITY OF BELOIT

(Signed) Edward Ruger

County Surveyor.

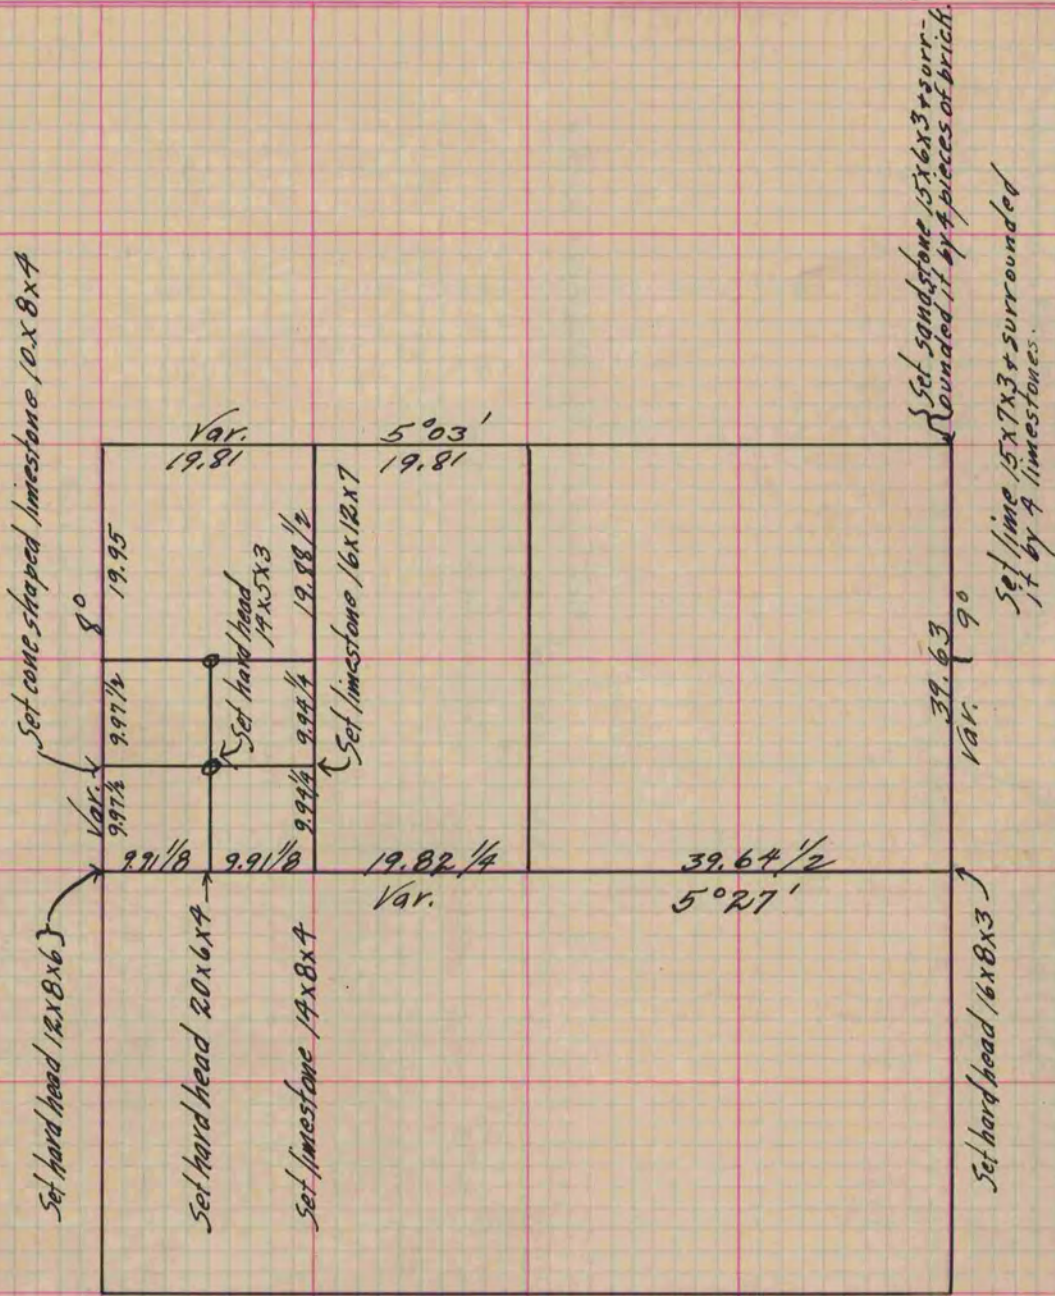

Copied from Page 172 Vol. One Original County Surveyors Record.