

# PLAT AND RECORD

Of a Survey on Section 13 T 3 R 13 E. of the 4 P. M. in Harmony Township


Rock County, Wisconsin, made May the 7th 1861

I hereby certify that the following is a correct record of said survey as made by me.

COUNTY BUILDING  
IN CITY OF БЕЛОIT

(Signed) Edward Ruger.

County Surveyor.

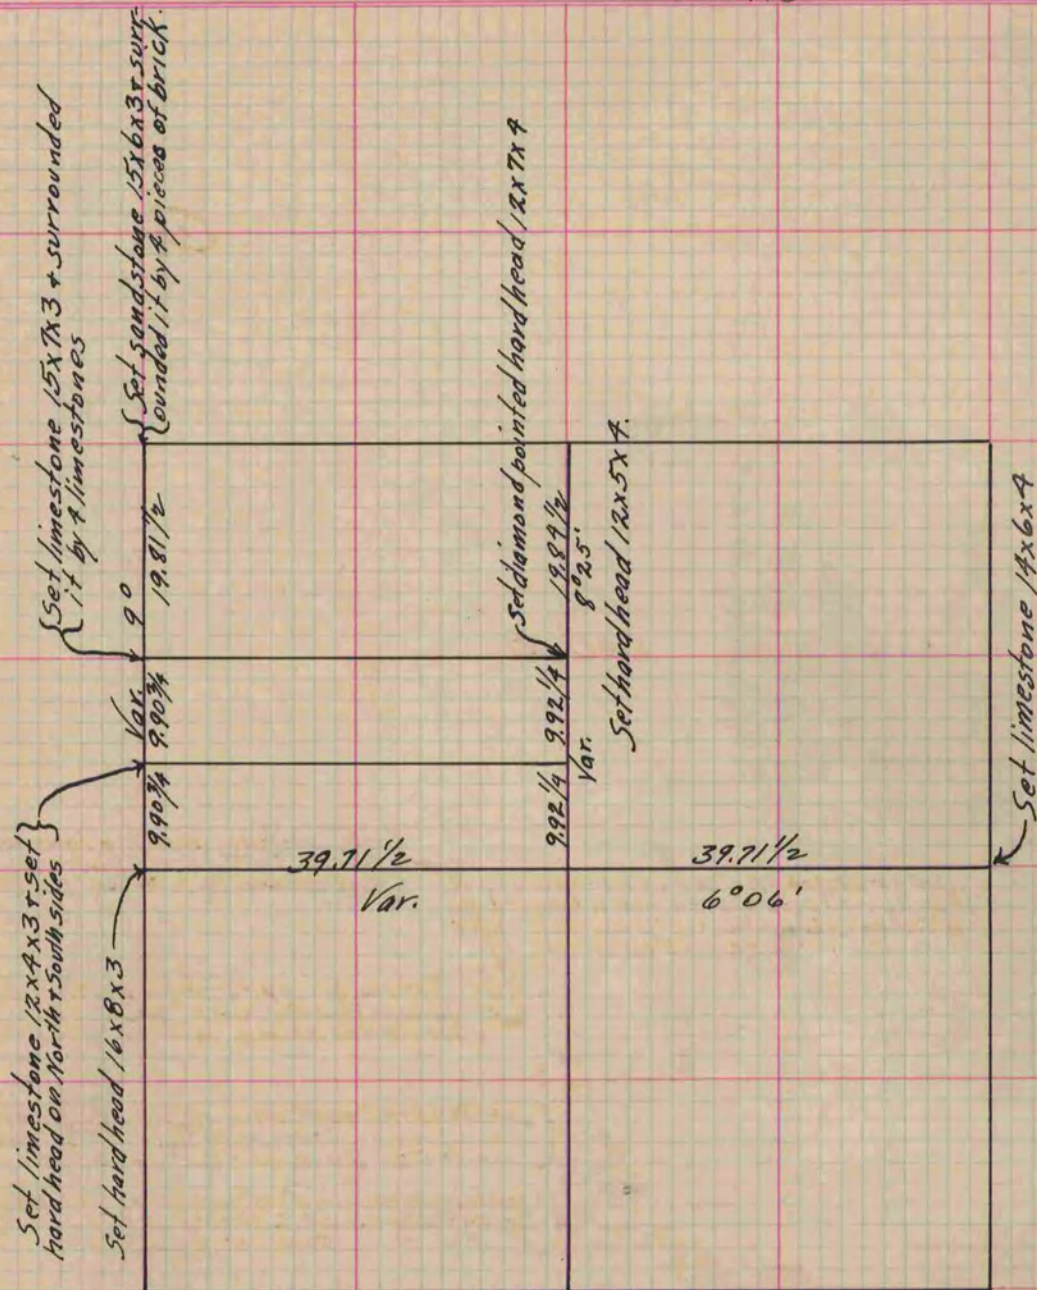

Copied from Page 173 Vol. One. Original County Surveyor's Record.