

# PLAT AND RECORD


Of a Survey on Section 15 T 2 R 12 E. of the 4 P. M. in Rock Township  
Rock County, Wisconsin, made June the 8<sup>th</sup> 1861

I hereby certify that the following is a correct record of said survey as made by me.

COUNTY BUILDING  
IN CITY OF БЕЛОIT

(Signed) Edward Ruger.  
ER

County Surveyor.

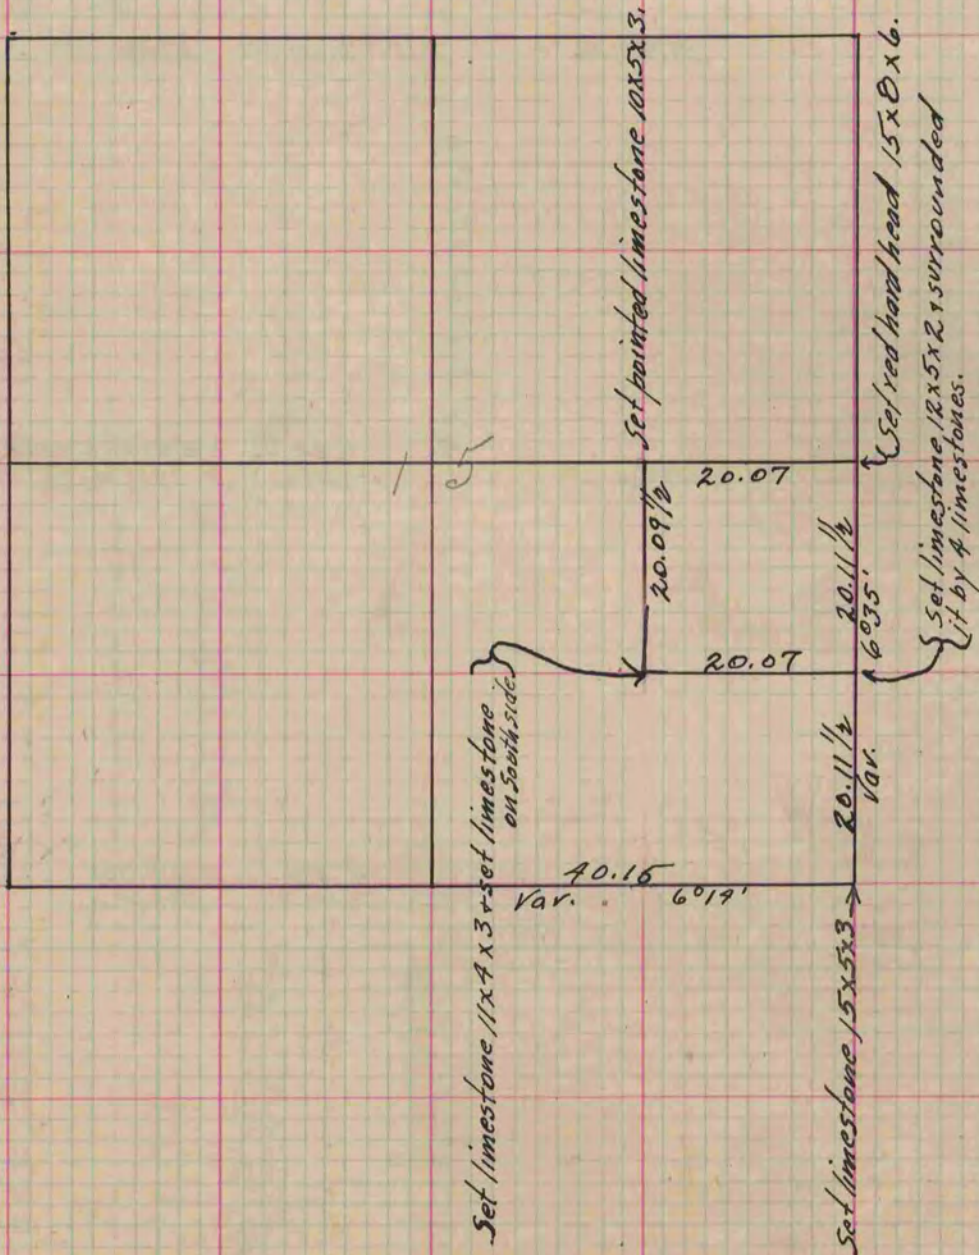

Copied from Page 177 Vol. 1. Original County Surveyor's Record.