

PLAT AND RECORD

Of a Survey on Section 30 T 3 R 14 E. of the 4 P. M. in Johnstown Township


Rock County, Wisconsin, made June the 18th 1861

I hereby certify that the following is a correct record of said survey as made by me.

COUNTY BUILDING
IN CITY OF BELOIT

(Signed) Edward Ruger
RMB

County Surveyor.

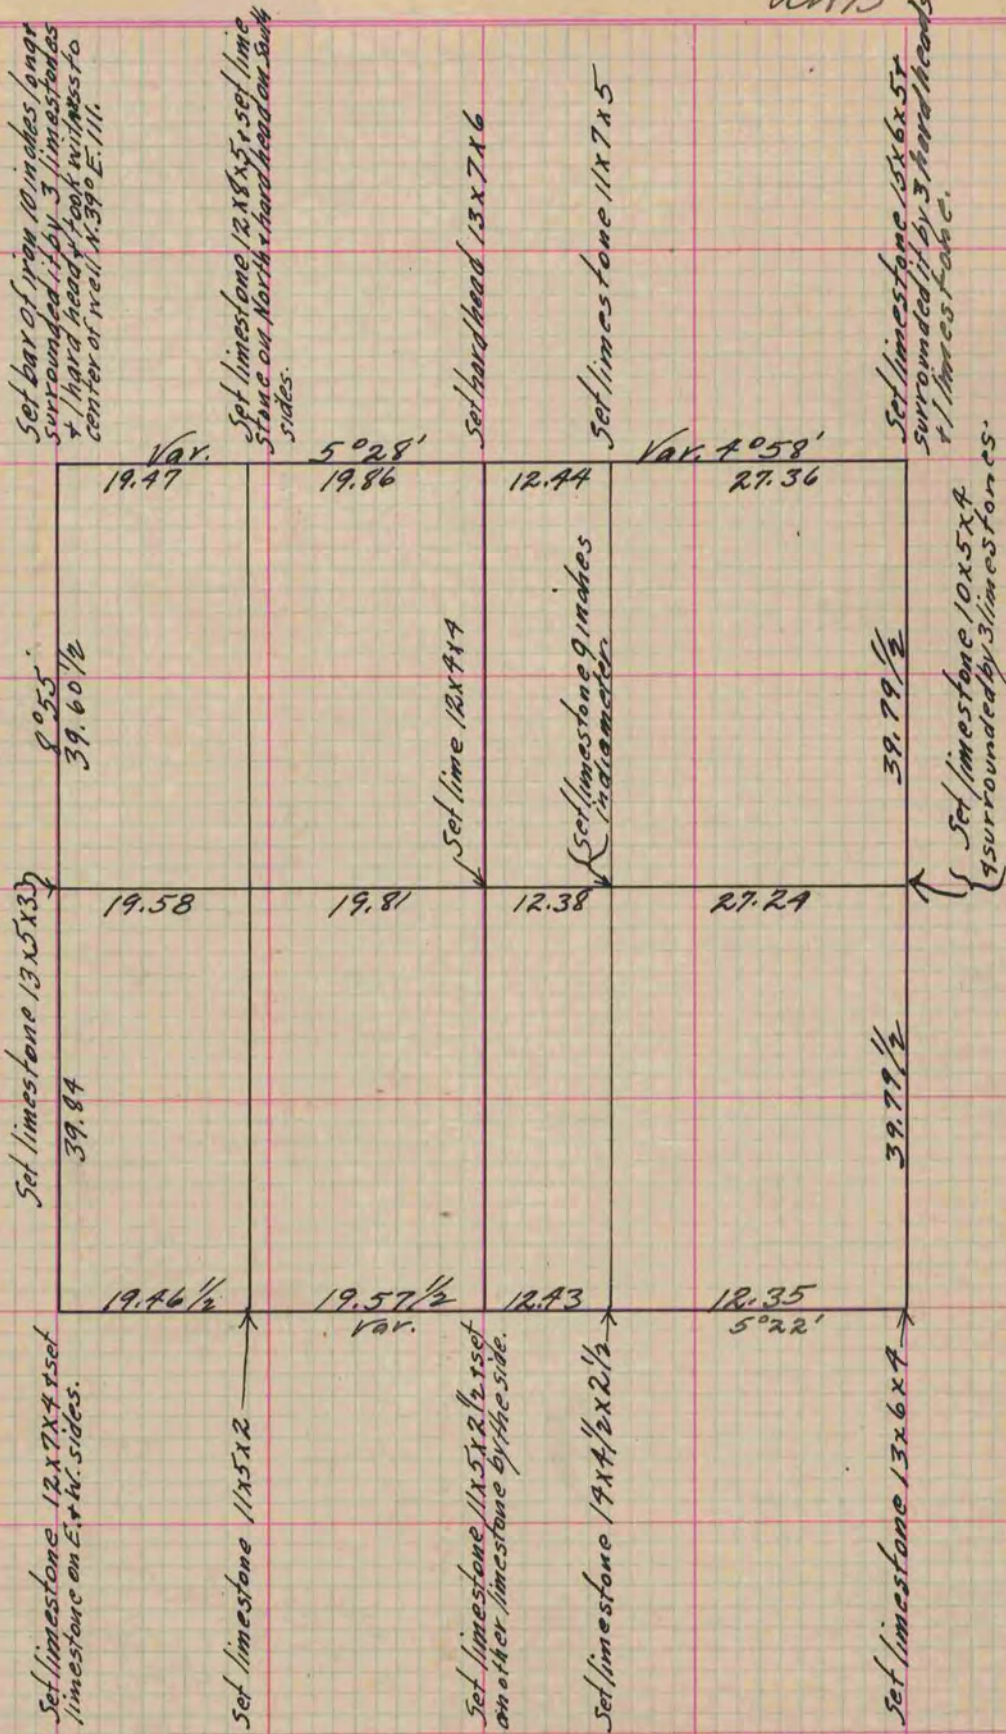

Copied from Page 178 Vol. 1. Original County Surveyors Record.