

PLAT AND RECORD

Of a Survey on Section 4 T 3 R 10 E. of the 4 P. M. in Magnolia Township


Rock County, Wisconsin, made Dec. 11th the 1863

I hereby certify that the following is a correct record of said survey as made by me.

COUNTY BUILDING
IN CITY OF BELOIT.

(Signed) S. D. Locke
[Signature]

County Surveyor.

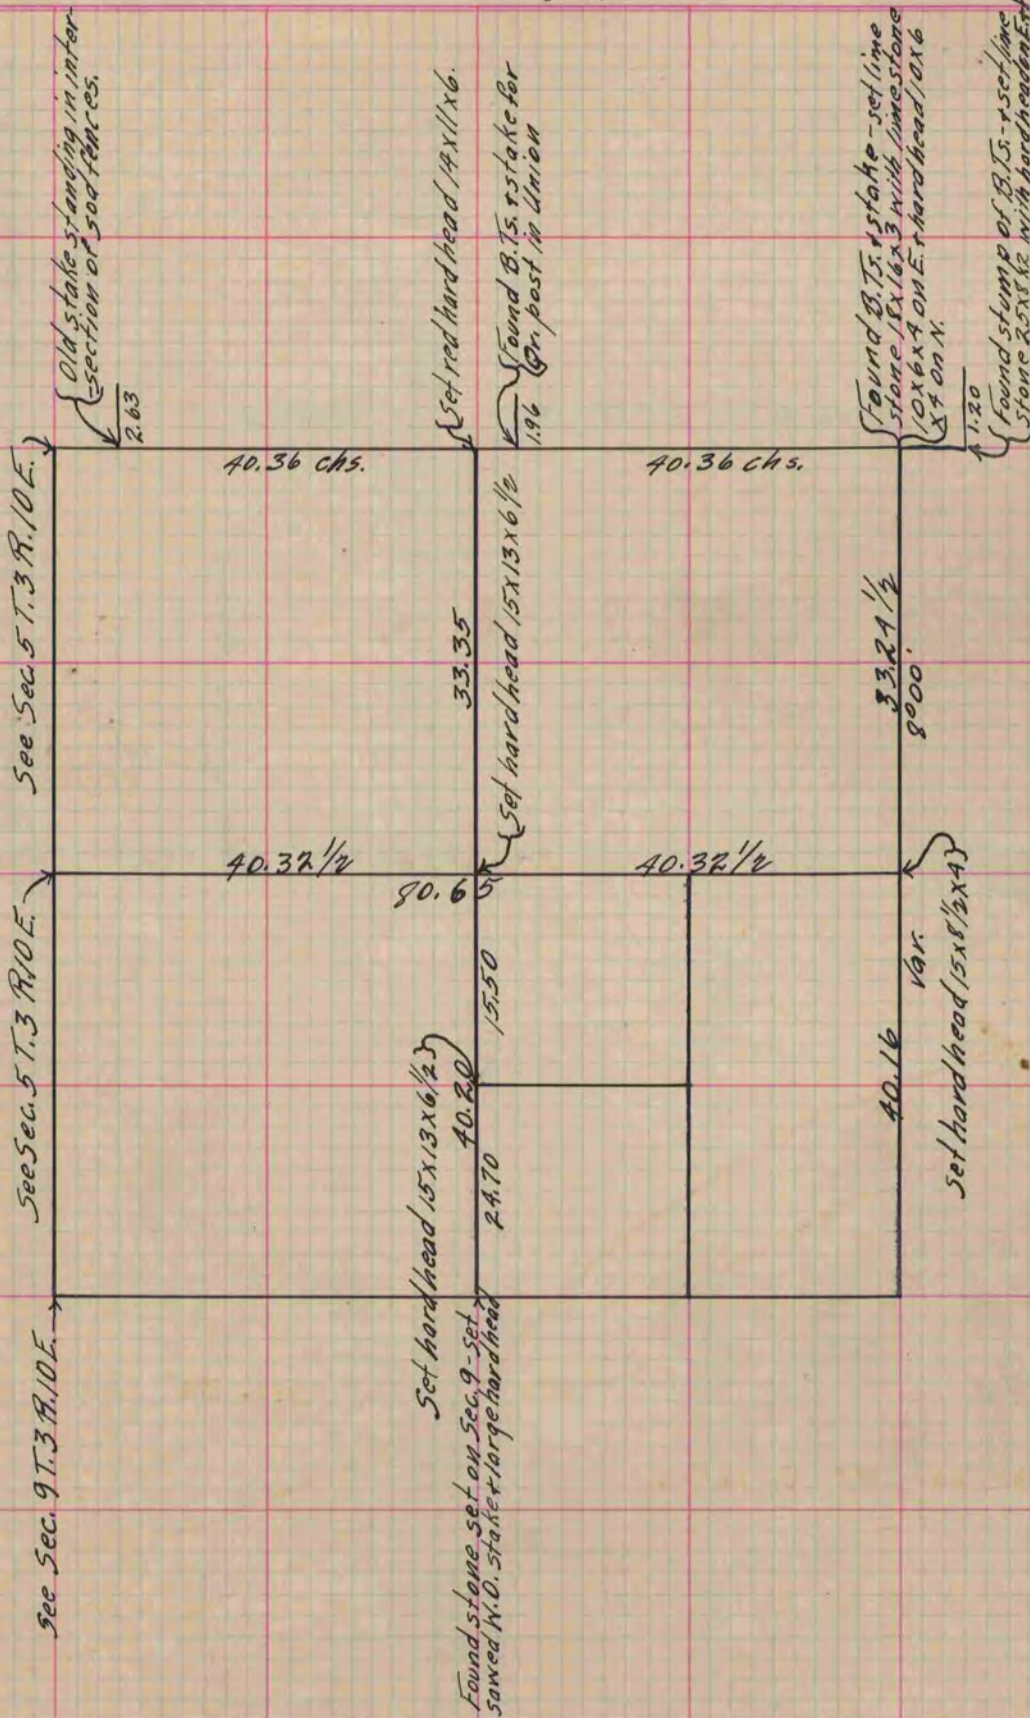

Copied from lower 1/2 of Page 198 Vol. 1. Original County Surveyors Record.