


# PLAT AND RECORD

187


Of a Survey on Section 9 T 3 R 13 E. of the 4 P. M. in Harmony Township  
 Rock County, Wisconsin, made July the 15<sup>th</sup> 1863

I hereby certify that the following is a correct record of said survey as made by me.

COUNTY BUILDING  
 IN CITY OF БЕЛОIT

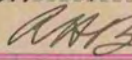(Signed) S. D. Locke.  


County Surveyor.

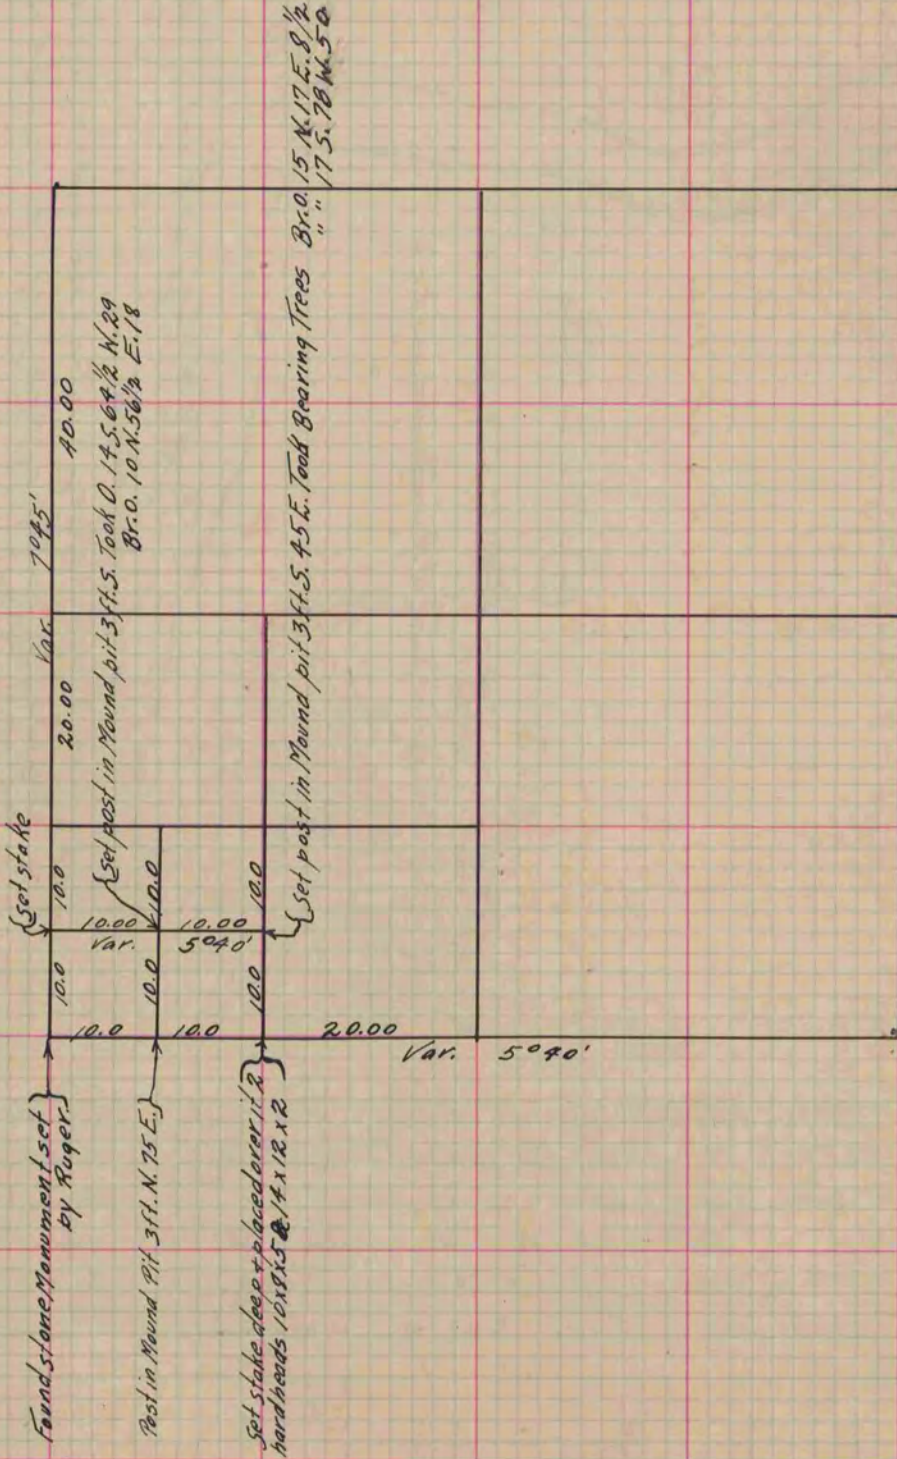

The above was only an approximate Survey. See Page 212. (223) this book)

Copied from lower part of page 193 Vol. One - Surveyor's Record.