

PLAT AND RECORD

Of a Survey on Section 25 3 10 Magnolia
36 3 10 Magnolia
30 T 3 R 11 E. of the 4 P. M. in Center Township
31 3 11 Center
 Rock County, Wisconsin, made 29th of March to the 2nd of April 1957

I hereby certify that the following is a correct record of said survey as made by me.

Richard H. Batterman, Jr.
County Surveyor.


COUNTY BUILDING
IN CITY OF БЕЛОIT

MAGNOLIA TWP.
SEC. 25

CENTER TWP.
SEC. 30

Ties to edge at angle
pt on N. face of wing

DUG 24'x8'x6' hole
 Found SANDSTONE 20"x10"x8"
 5ft. deep. Set 2" Pipe over stone.
 Reset 1 1/2" pipe in new
 blacktop 7/9/58.
 1" Pipe

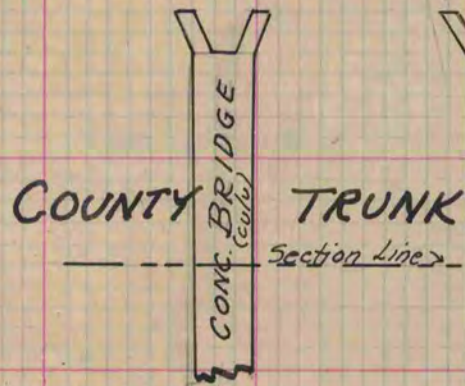


Ties to edge at angle
Pt. on S. Face of wing

Dug hole 4'x8'x6' deep.
 Found old Sandstone broken.
 Took center of same and found
 distance to be same as records
 show - 28.38. Set 2" Pipe over stone
 Reset 1 1/2" pipe in new blacktop 7/9/58

MAGNOLIA TWP.
SEC. 36

CENTER TWP.
SEC. 31

Ties to inside edge
at L Pt. on wing

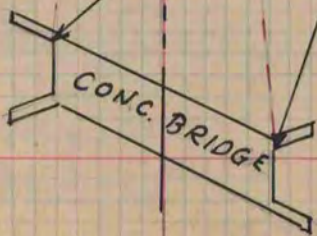

Field work by the following
 T. R. Dull
 S. R. Cushman
 R. H. Batterman III
 Tom Walsh
 Larry McKay