

# PLAT AND RECORD

Of a Survey on Section 6 & 7 T 3 R 13 E. of the 4 P. M. in Harmony Township  
Rock County, Wisconsin, made May the 24<sup>th</sup> 1861


I hereby certify that the following is a correct record of said survey as made by me.

COUNTY BUILDING  
IN CITY OF BELLOIT

(Signed) Edward Ruger.  
ERT

County Surveyor.

*Survey made in altering highway in Sections 6 & 7 of Town 3 Range 13 between points A & B. Point marked A is the S.E. section of section 31 T. 4 R. 13. Point marked "B" is a point mentioned in description of former Roadas being outline between lands owned by Harvey Story and James M. Kearns. Var. 8° East.*

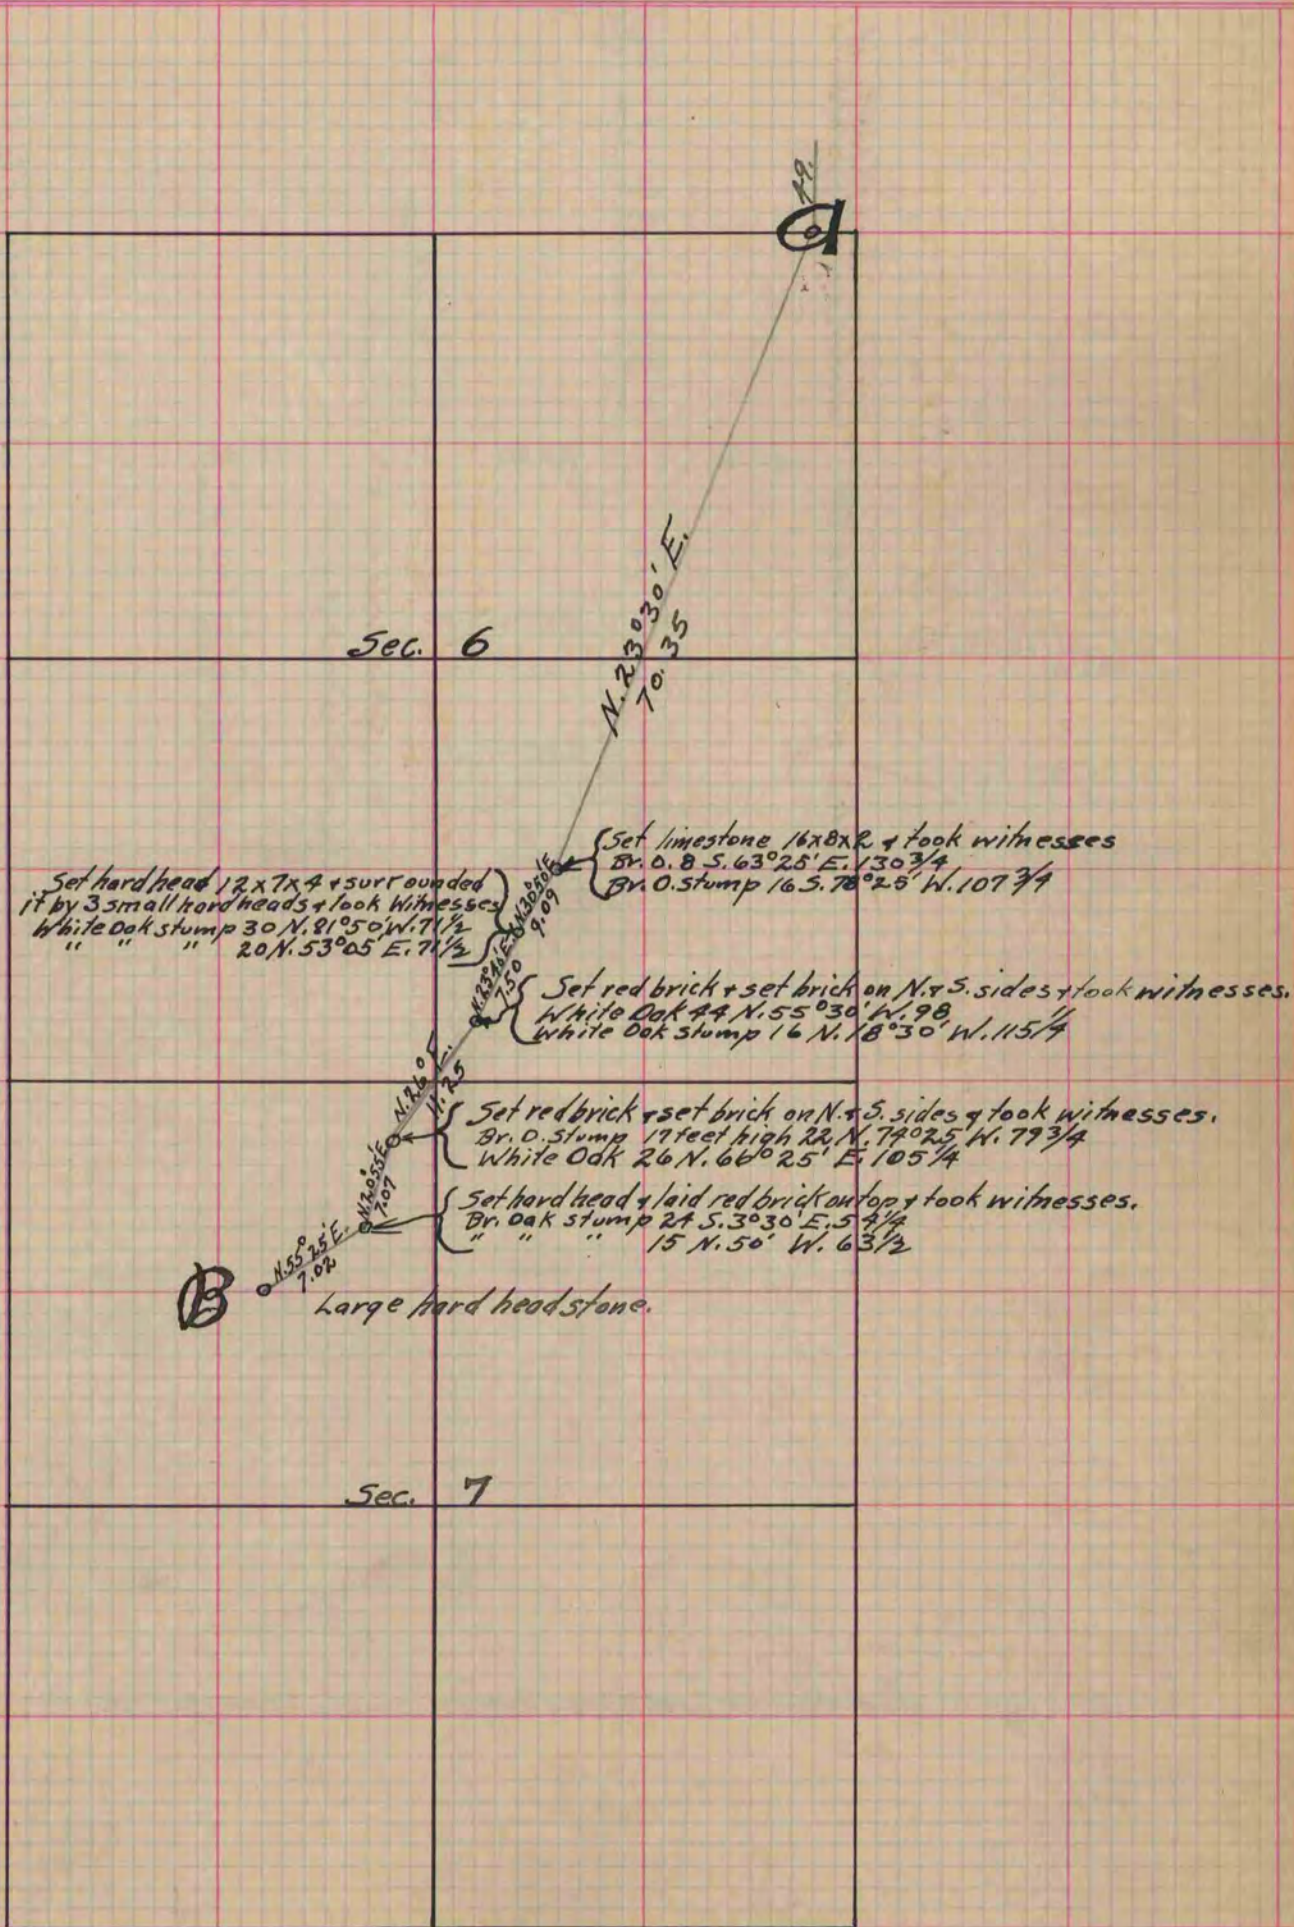

*Copied from Page 174 Vol. One Original County Surveyor's Record.*