

PLAT AND RECORD


Of a Survey on Section 36 T 3 R 13 E. of the 4 P. M. in Harmony Township
Rock County, Wisconsin, made May the 30th 1860

I hereby certify that the following is a correct record of said survey as made by me.

COUNTY BUILDING
IN CITY OF BELOIT

(Signed) *Edward Ruger*

County Surveyor.

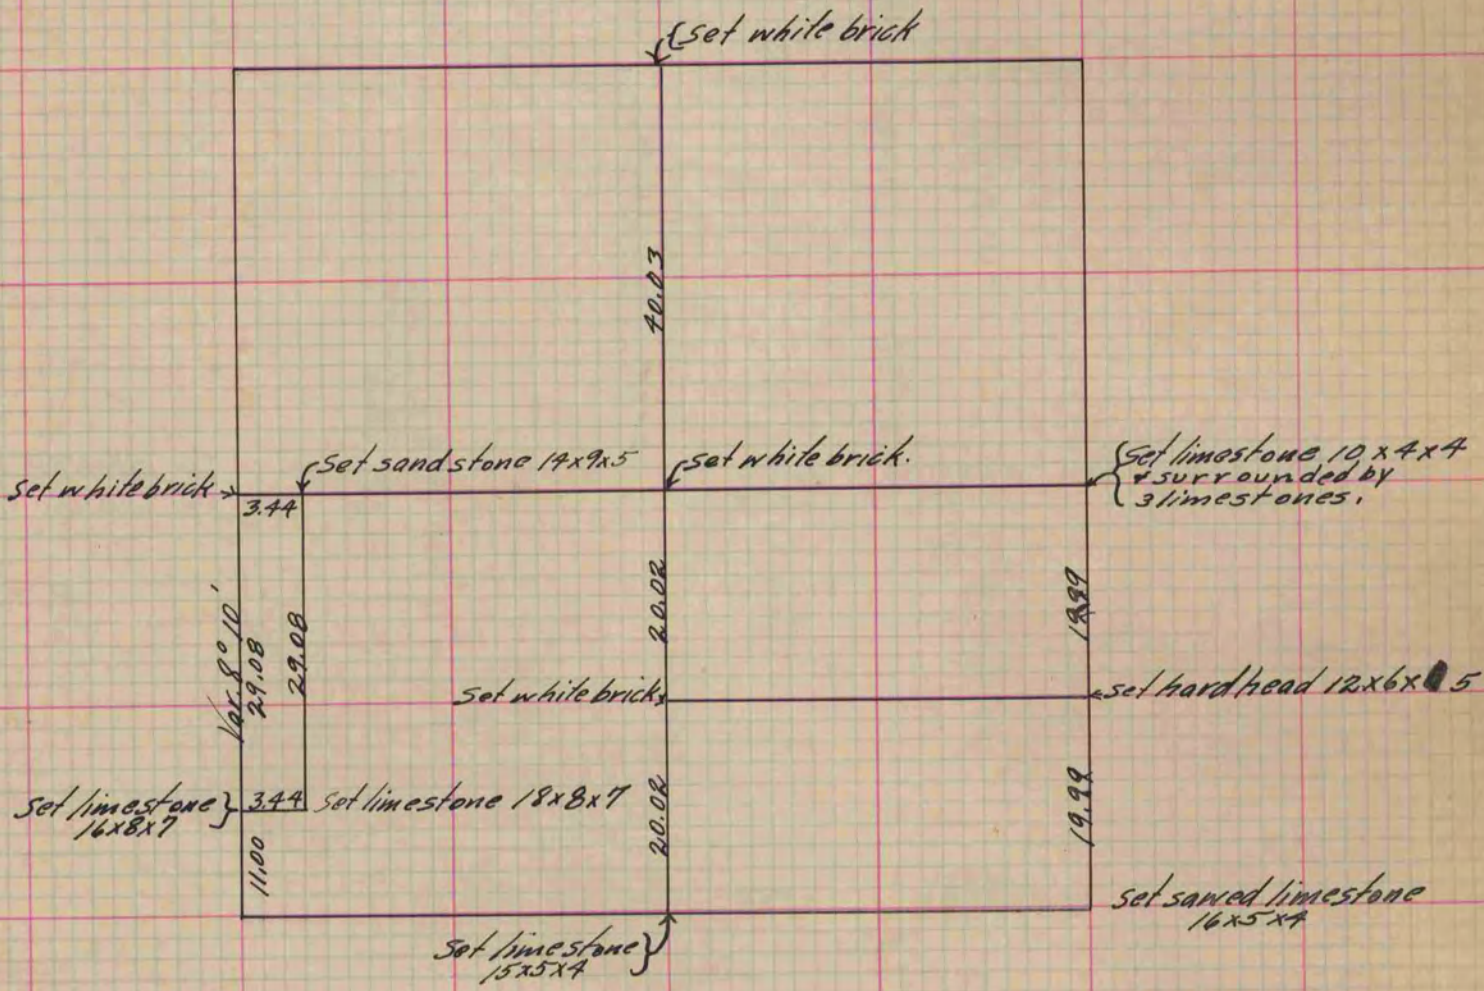

Copied from Page 144 Vol. 1 Original County Surveyor's Record.