


PLAT AND RECORD

Of a Survey on Section 34 T 4 R 11 E. of the 4 P. M. in Porter Township
Rock County, Wisconsin, made March the 30th 1861

I hereby certify that the following is a correct record of said survey as made by me.

COUNTY BUILDING
IN CITY OF БЕЛОIT

(Signed) Edward Ruger.
Edw. Ruger County Surveyor.

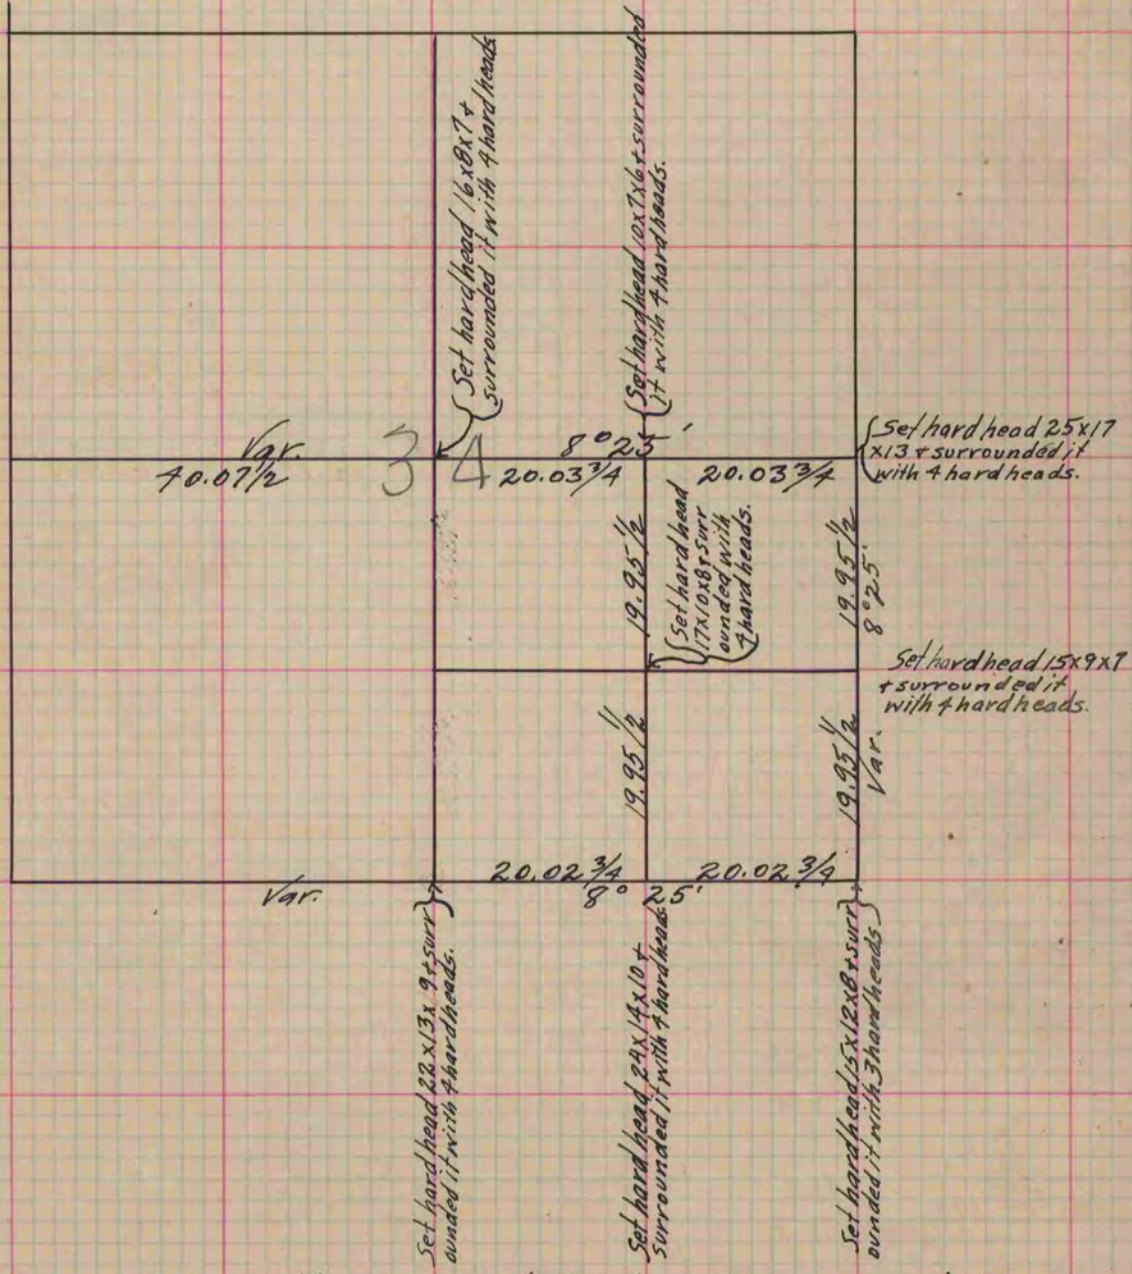

Copied from Page 165 Vol. one Original County Surveyors Record.