


PLAT AND RECORD

Of a Survey on Section 2 T 3 R 12 E. of the 4 P. M. in Janesville Township
Rock County, Wisconsin, made March the 11th 1861

I hereby certify that the following is a correct record of said survey as made by me.

COUNTY BUILDING
IN CITY OF BELOIT

(Signed) Edward Ruger.
ERUGER County Surveyor.

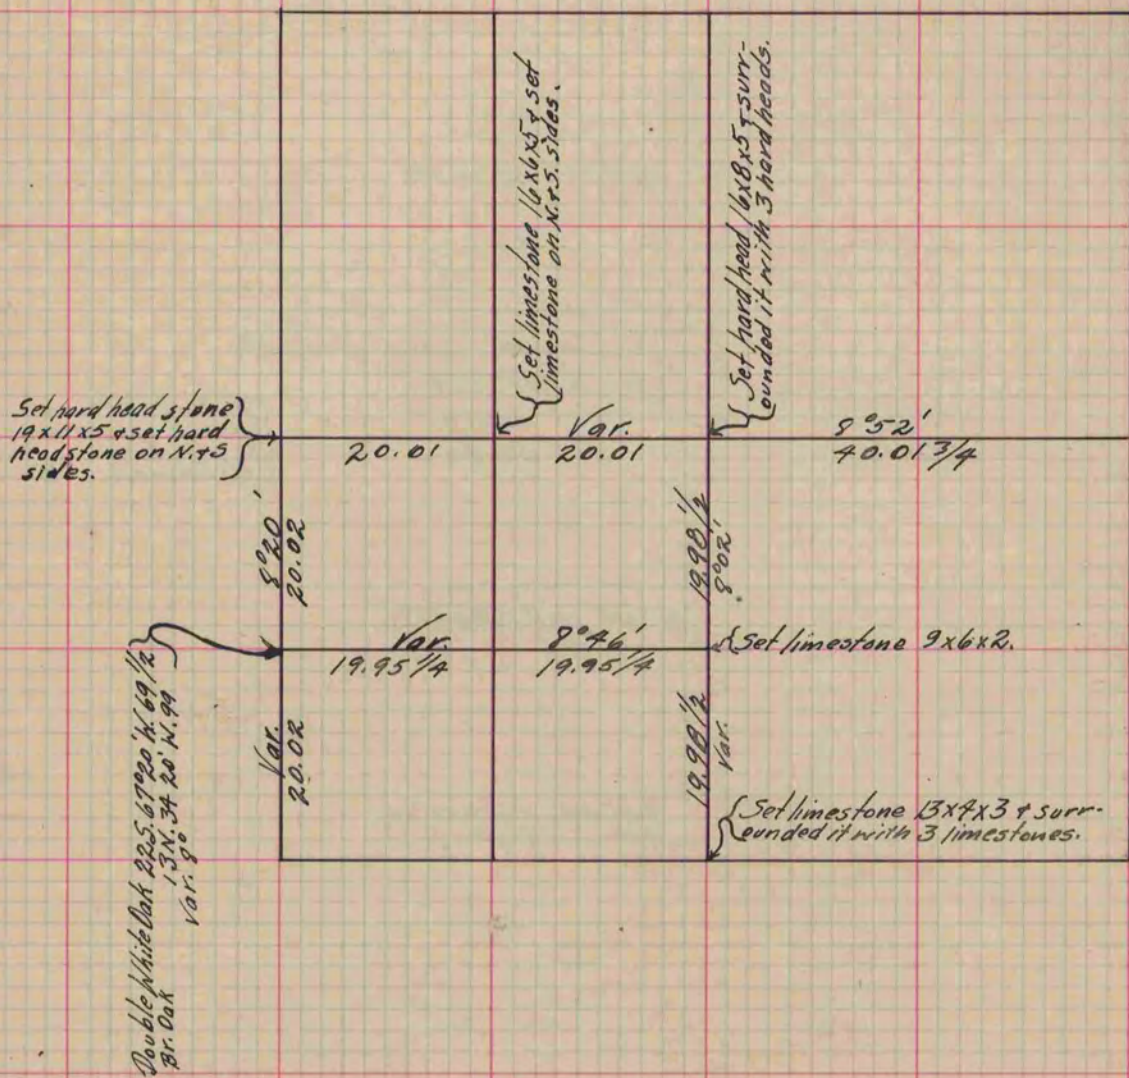

Copied from Page 162 Vol. 1. Original County Surveyor's Record.