

# PLAT AND RECORD

Of a Survey on Section 31 T 2 R 10 E. of the 4 P. M. in Spring Valley Township


Rock County, Wisconsin, made April the 7th 1874

I hereby certify that the following is a correct record of said survey as made by me.

COUNTY BUILDING  
IN CITY OF BELLOIT

(Signed) Edward Ruger.  
R.R.G.

County Surveyor.

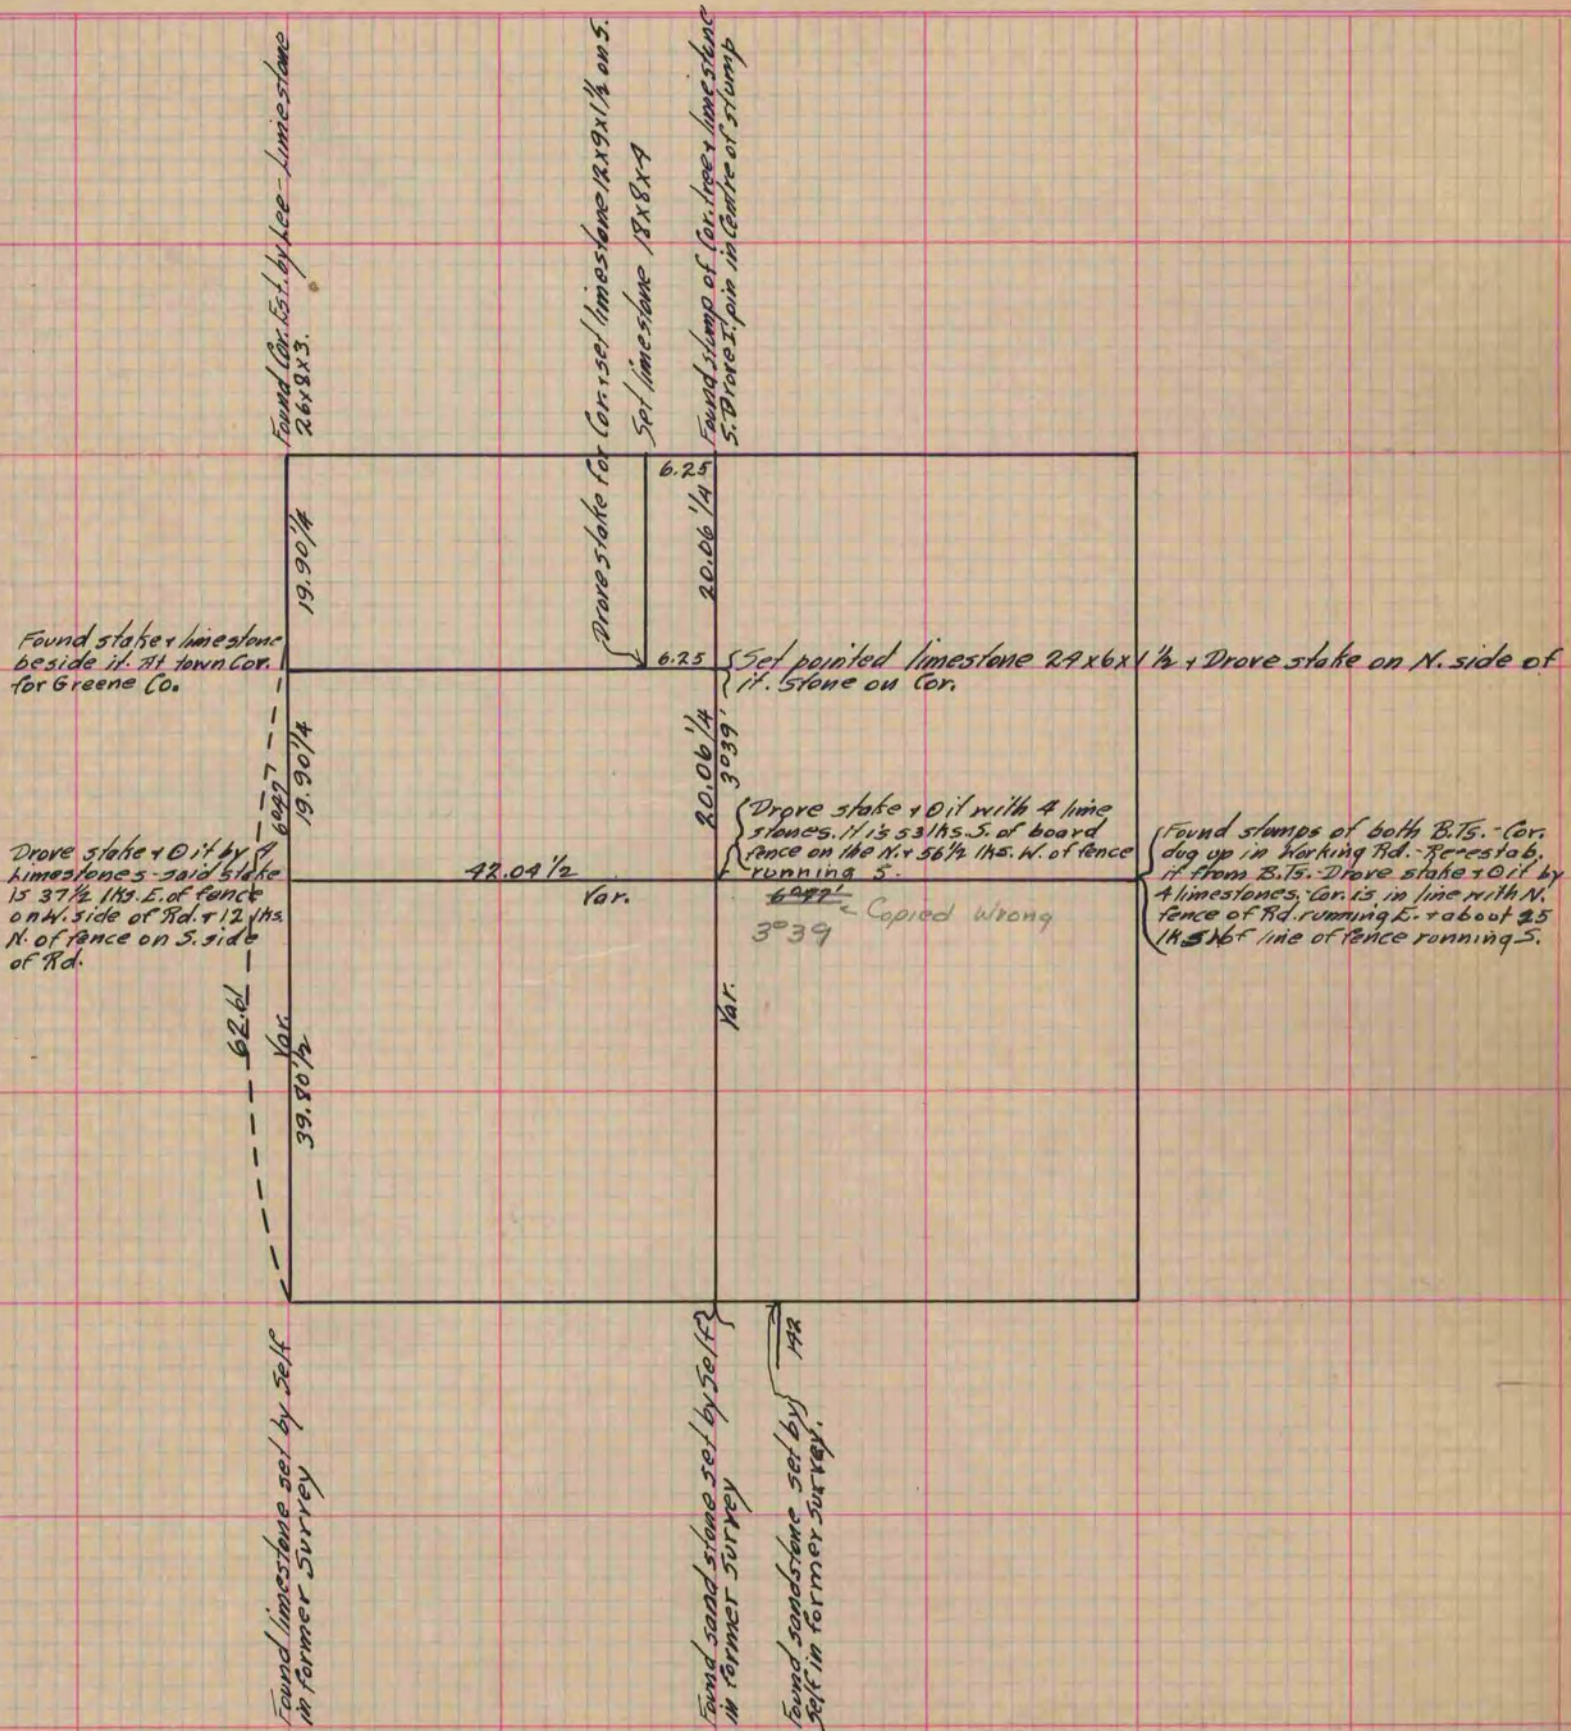

Copied from P. 89 Vol. 2. Original County Surveyors Record.