

PLAT AND RECORD

Of a Survey on Section 8 T 2 R 13 E. of the 4 P. M. in La Prairie Township
Rock County, Wisconsin, made May the 2nd 1861


I hereby certify that the following is a correct record of said survey as made by me.

COUNTY BUILDING
IN CITY OF BELOIT

(Signed) *Edward Ruger.*
ERUG

County Surveyor.

Set limestone $16 \times 5 \times 2\frac{1}{2}$

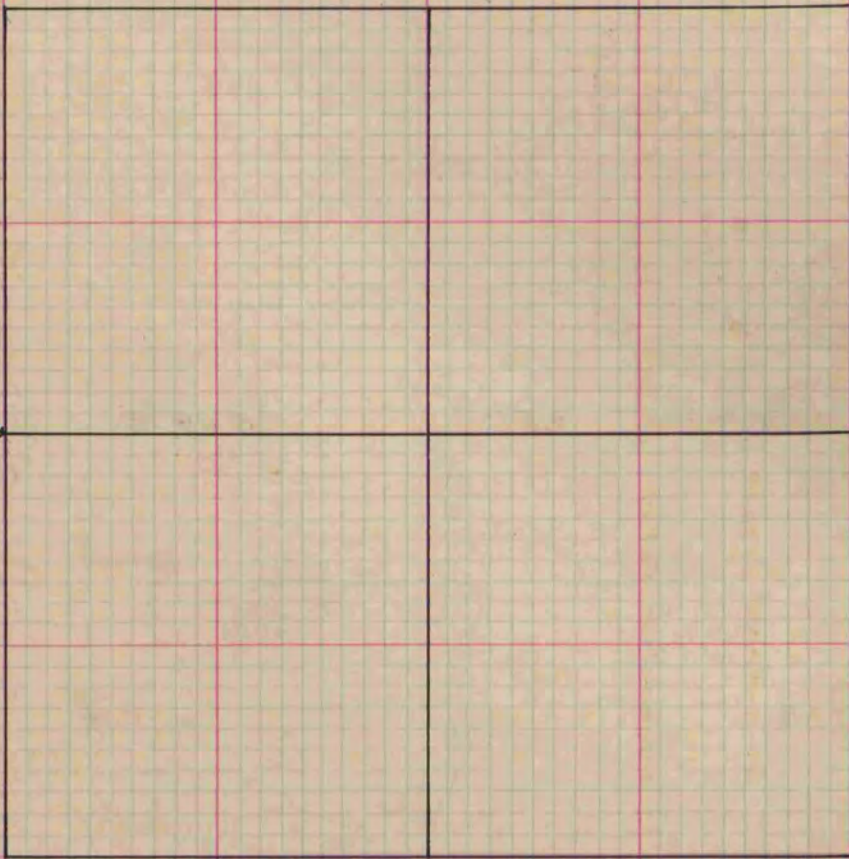

Copied from Page 171 Vol. One Original County Surveyor's Record.