

PLAT AND RECORD

123


Of a Survey on Section 15 T 4 R 12 E. of the 4 P. M. in Fulton Township
Rock County, Wisconsin, made December the 24th 1859

I hereby certify that the following is a correct record of said survey as made by me.

COUNTY BUILDING
IN CITY OF BELoit

(Signed) Edward Ruger

County Surveyor.

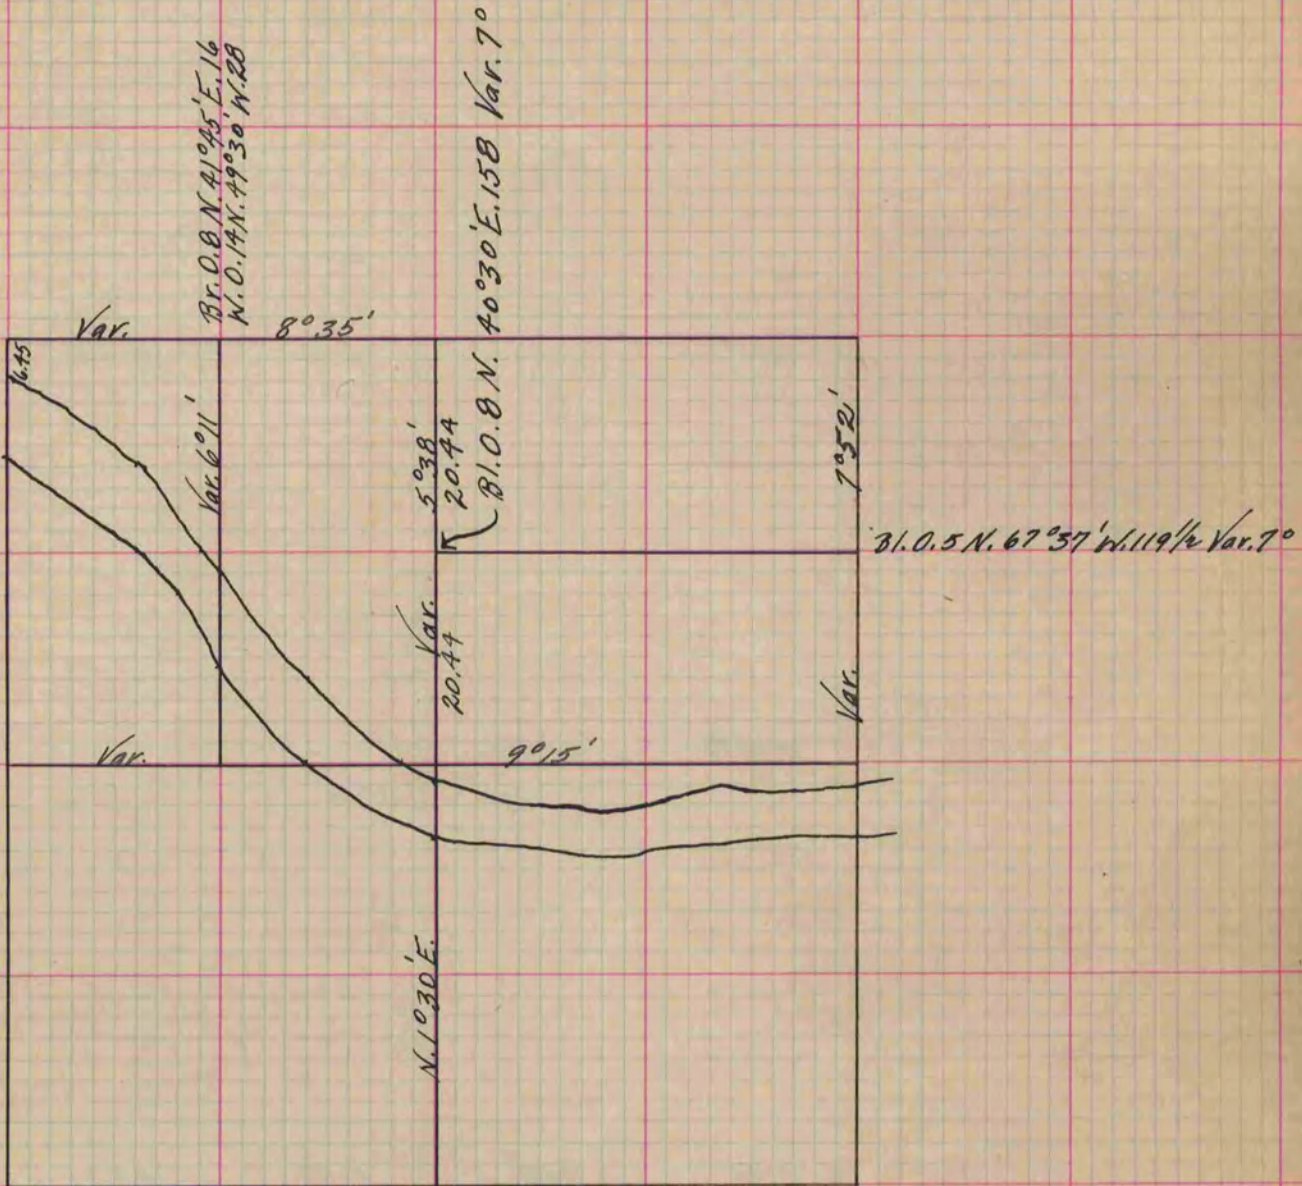

Copied from Page 132 Vol. One Original County Surveyor's Record.