

# PLAT AND RECORD

Of a Survey on Section 10 T 4 R 12 E. of the 4 P. M. in Fulton Township


Rock County, Wisconsin, made December the 26<sup>th</sup> 1858

I hereby certify that the following is a correct record of said survey as made by me.

COUNTY BUILDING  
IN CITY OF BELOIT

(Signed) *Edward Ruger*

County Surveyor.

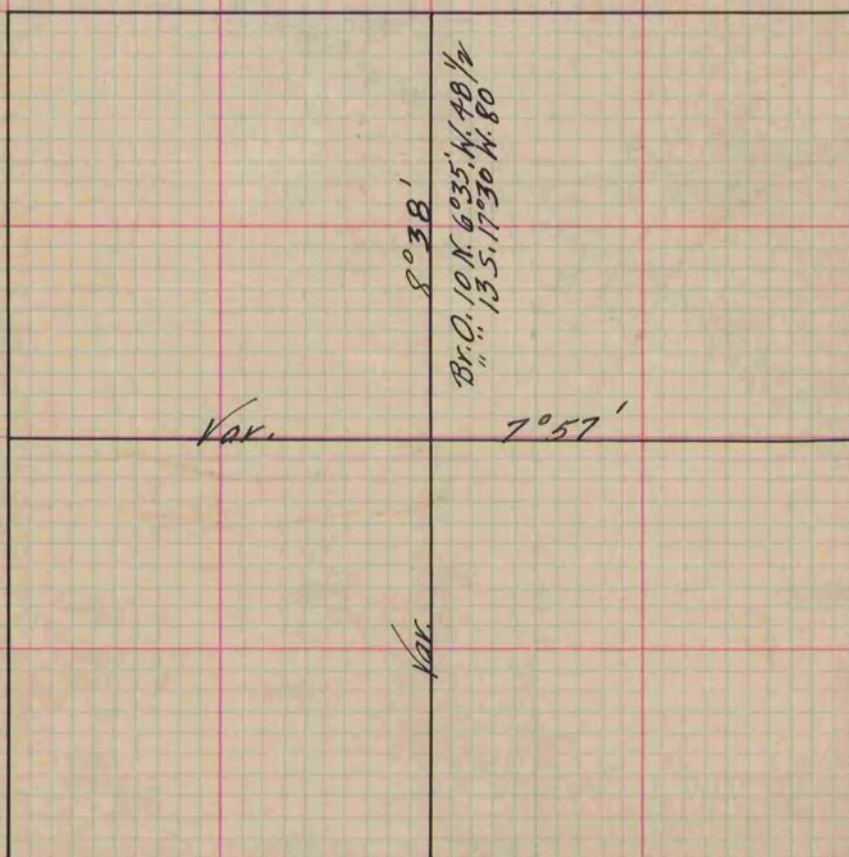

*Copied from Page 131 Vol. 1 Original County Surveyor's Record.*