

# PLAT AND RECORD

Of a Survey on Section 34 T 3 R 14 E. of the 4 P. M. in Johnstown Township


Rock County, Wisconsin, made Nov. 1st the 1864

I hereby certify that the following is a correct record of said survey as made by me.

COUNTY BUILDING  
IN CITY OF БЕЛОIT

(Signed) S. D. Locke  
RALB

County Surveyor.

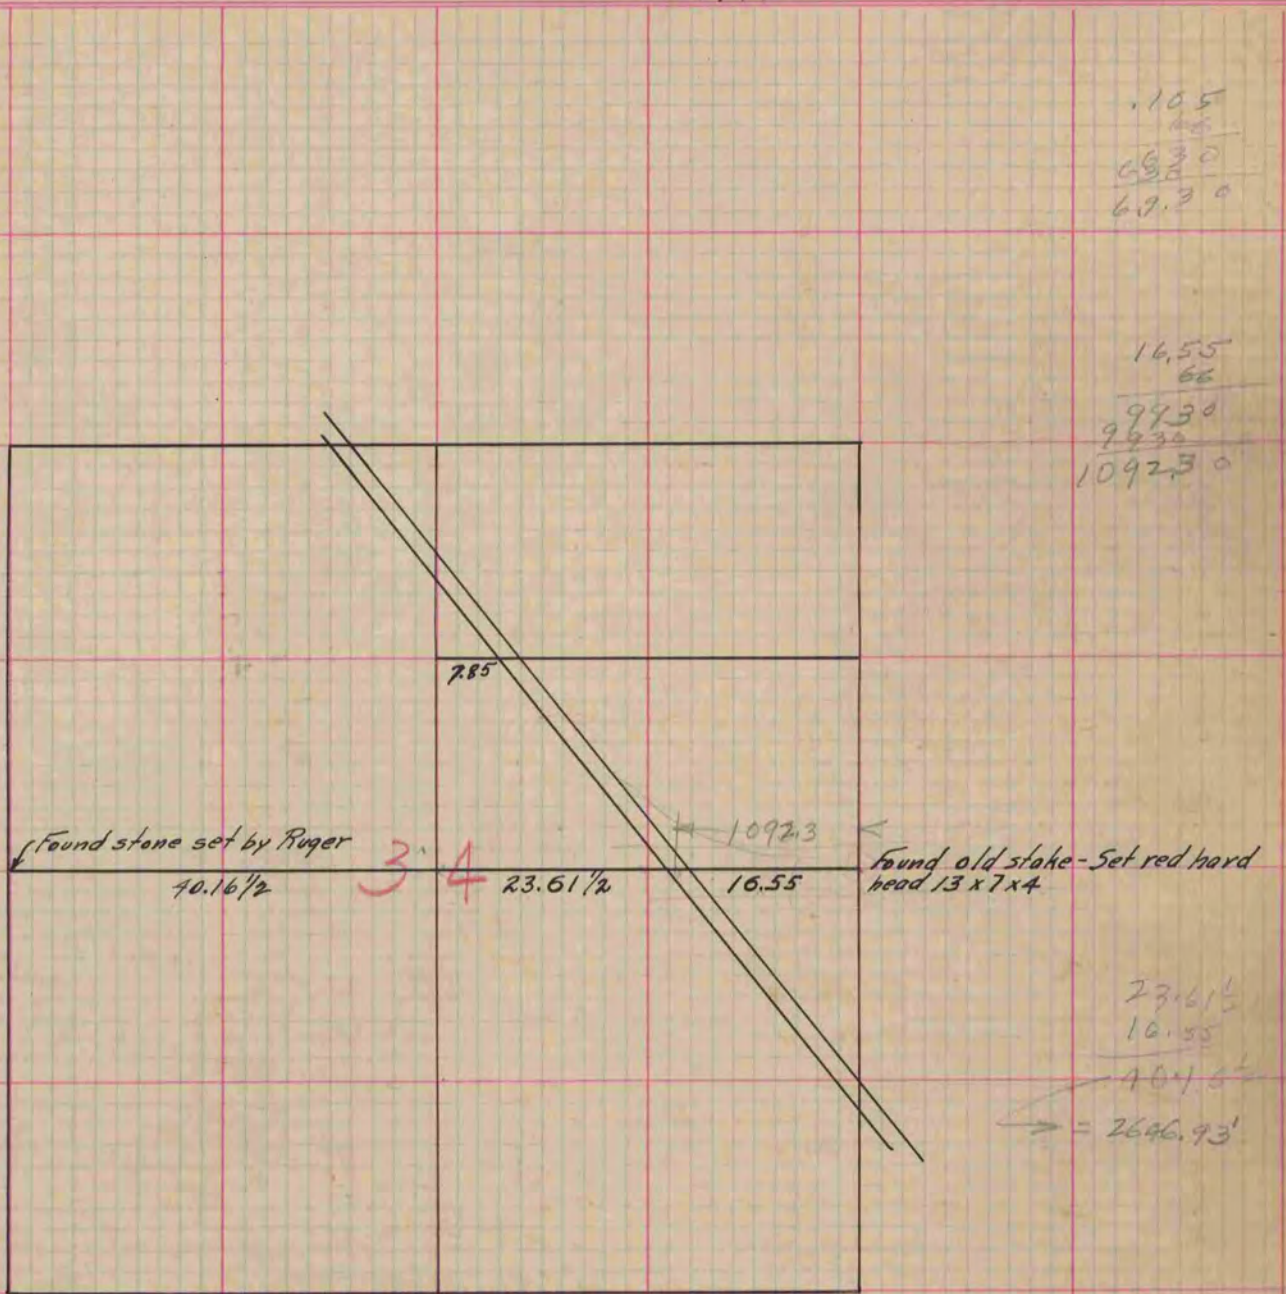

Copied from Upper 1/2 of Page 211 Vol. 1. Original County Surveyor's Record.

*[Faint handwritten text]*