


PLAT AND RECORD

Of a Survey on Section 33 T 2 R 10 E. of the 4 P. M. in Spring Valley Township
 Rock County, Wisconsin, made June the 19th & 20 1866

I hereby certify that the following is a correct record of said survey as made by me.

COUNTY BUILDING
 IN CITY OF BELoit

(Signed) S. D. Locke
RAB County Surveyor.

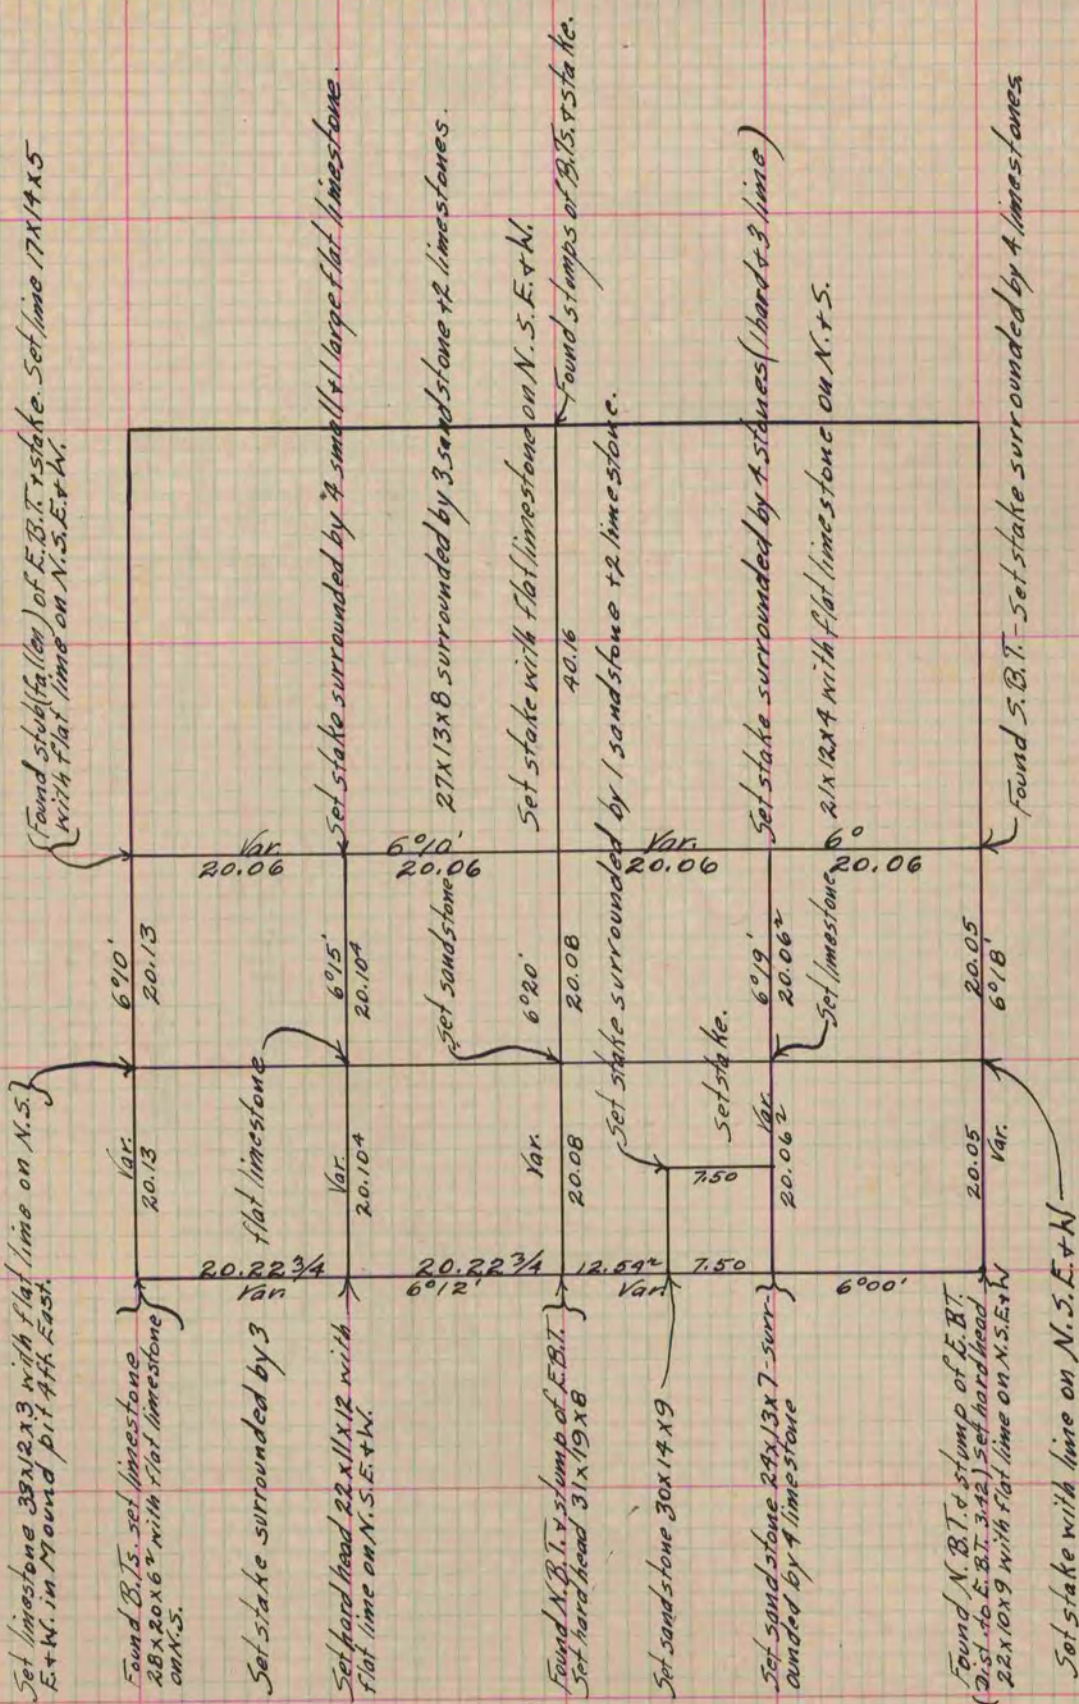

Copied from Page 234 Vol. 1. Original County Surveyor's Records.