

PLAT AND RECORD


Of a Survey on Section 17 T 2 R 12 E. of the 4 P. M. in Rock Township

Rock County, Wisconsin, made March the 29th 1860

I hereby certify that the following is a correct record of said survey as made by me.

COUNTY BUILDING
IN CITY OF BELOIT

(Signed) Edward Ruger
CRB County Surveyor.

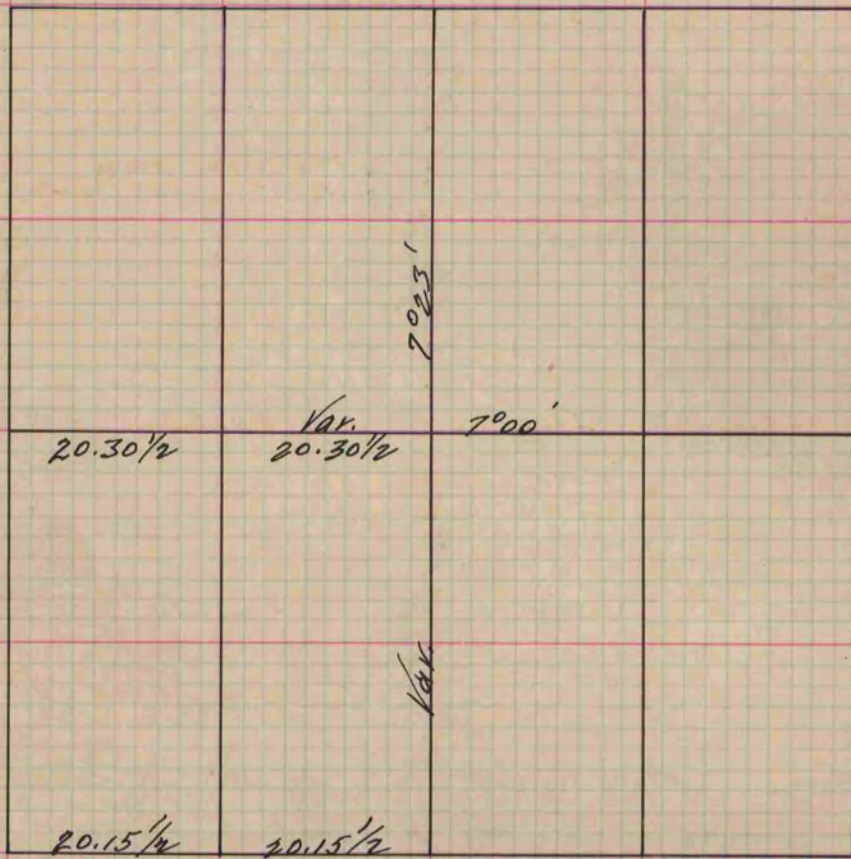

Copied from Page 137 Vol. 1. Original County Surveyors Record.