


PLAT AND RECORD

Of a Survey on Section 13 T 2 R 11 E. of the 4 P. M. in Plymouth Township
Rock County, Wisconsin, made July the 14th 1861

I hereby certify that the following is a correct record of said survey as made by me.

COUNTY BUILDING
IN CITY OF BELOIT

(Signed) Edward Ruger
ERS County Surveyor.

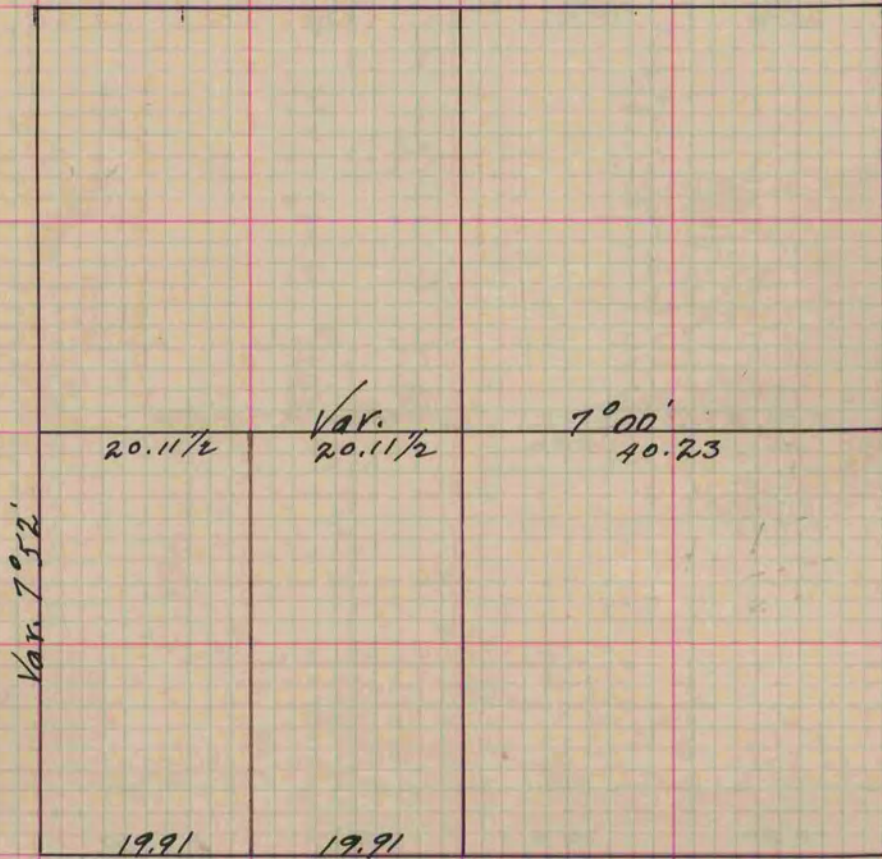

Copied from Page 181 Vol. 11 County Surveyor's Record.