


PLAT AND RECORD

Of a Survey on Section 31 T 4 R 12 E. of the 4 P. M. in Fulton Township
Rock County, Wisconsin, made July the 2nd 1870

I hereby certify that the following is a correct record of said survey as made by me.

COUNTY BUILDING
IN CITY OF BELOIT

(Signed) Edward Ruger {Deputy
R.H.B. County Surveyor.

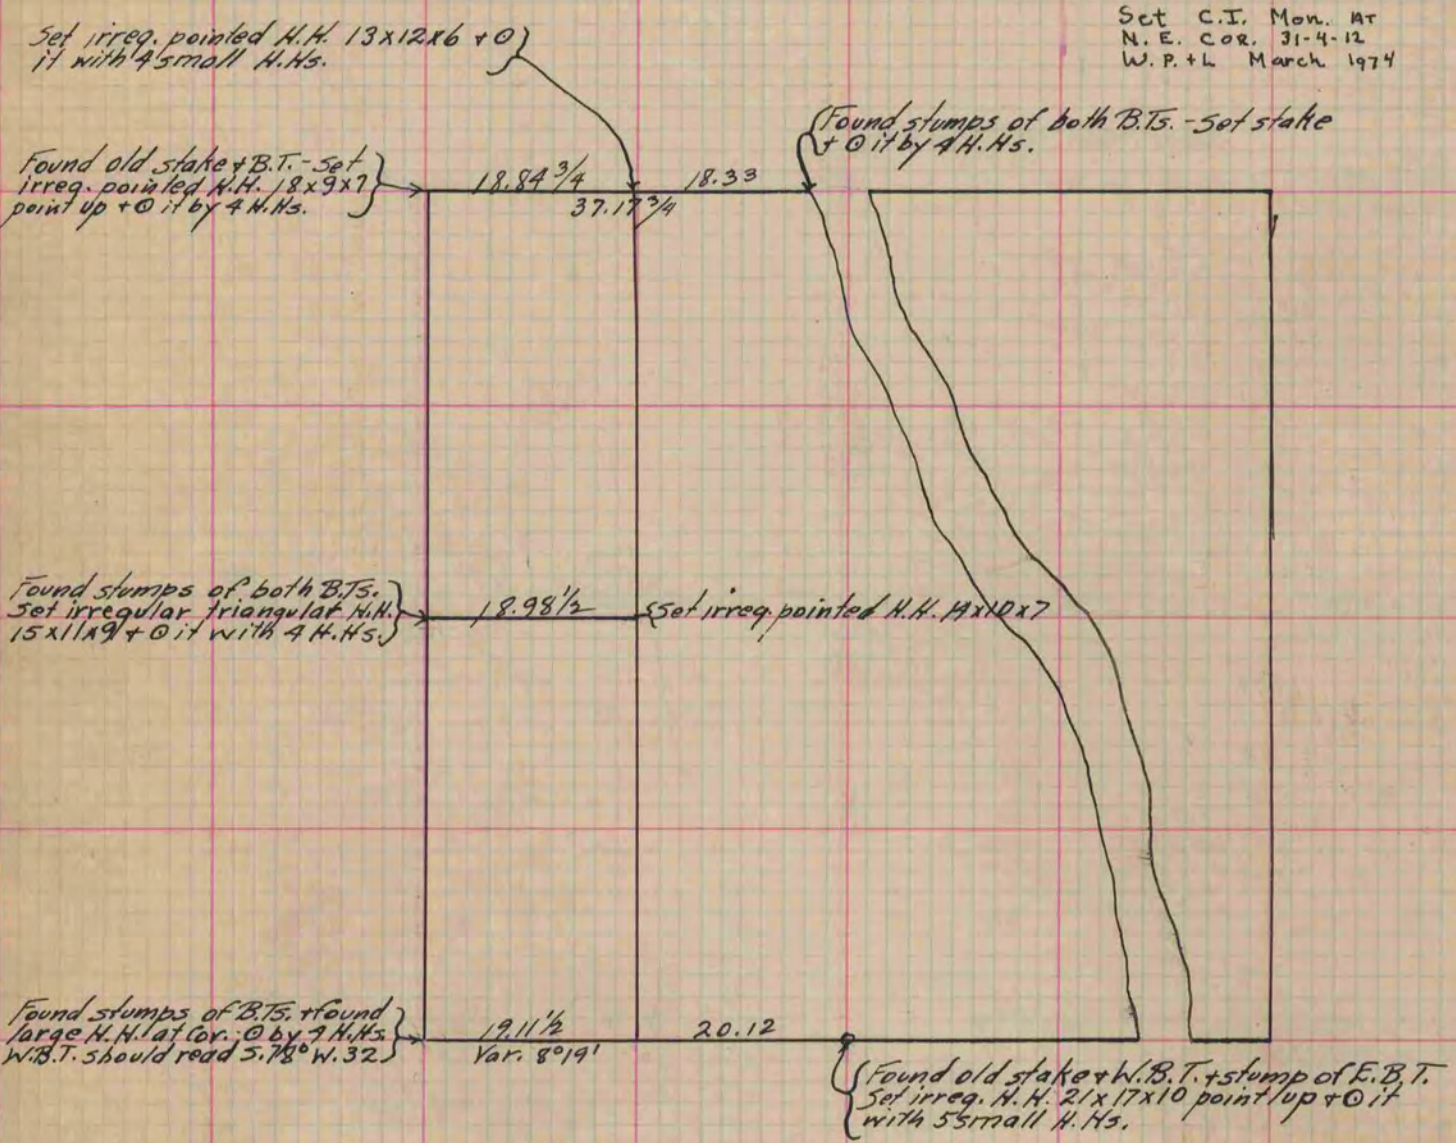

Copied from Page 24 Vol. 2 Original County Surveyor's Record.