


PLAT AND RECORD

Of a Survey on Section 6 T 2 R 12 E. of the 4 P. M. in Rock Township
Rock County, Wisconsin, made November the 9 + 10th 1870

I hereby certify that the following is a correct record of said survey as made by me.
**COUNTY BUILDING
IN CITY OF BELOIT**

(Signed) Edward Ruger DEPT.
County Surveyor.

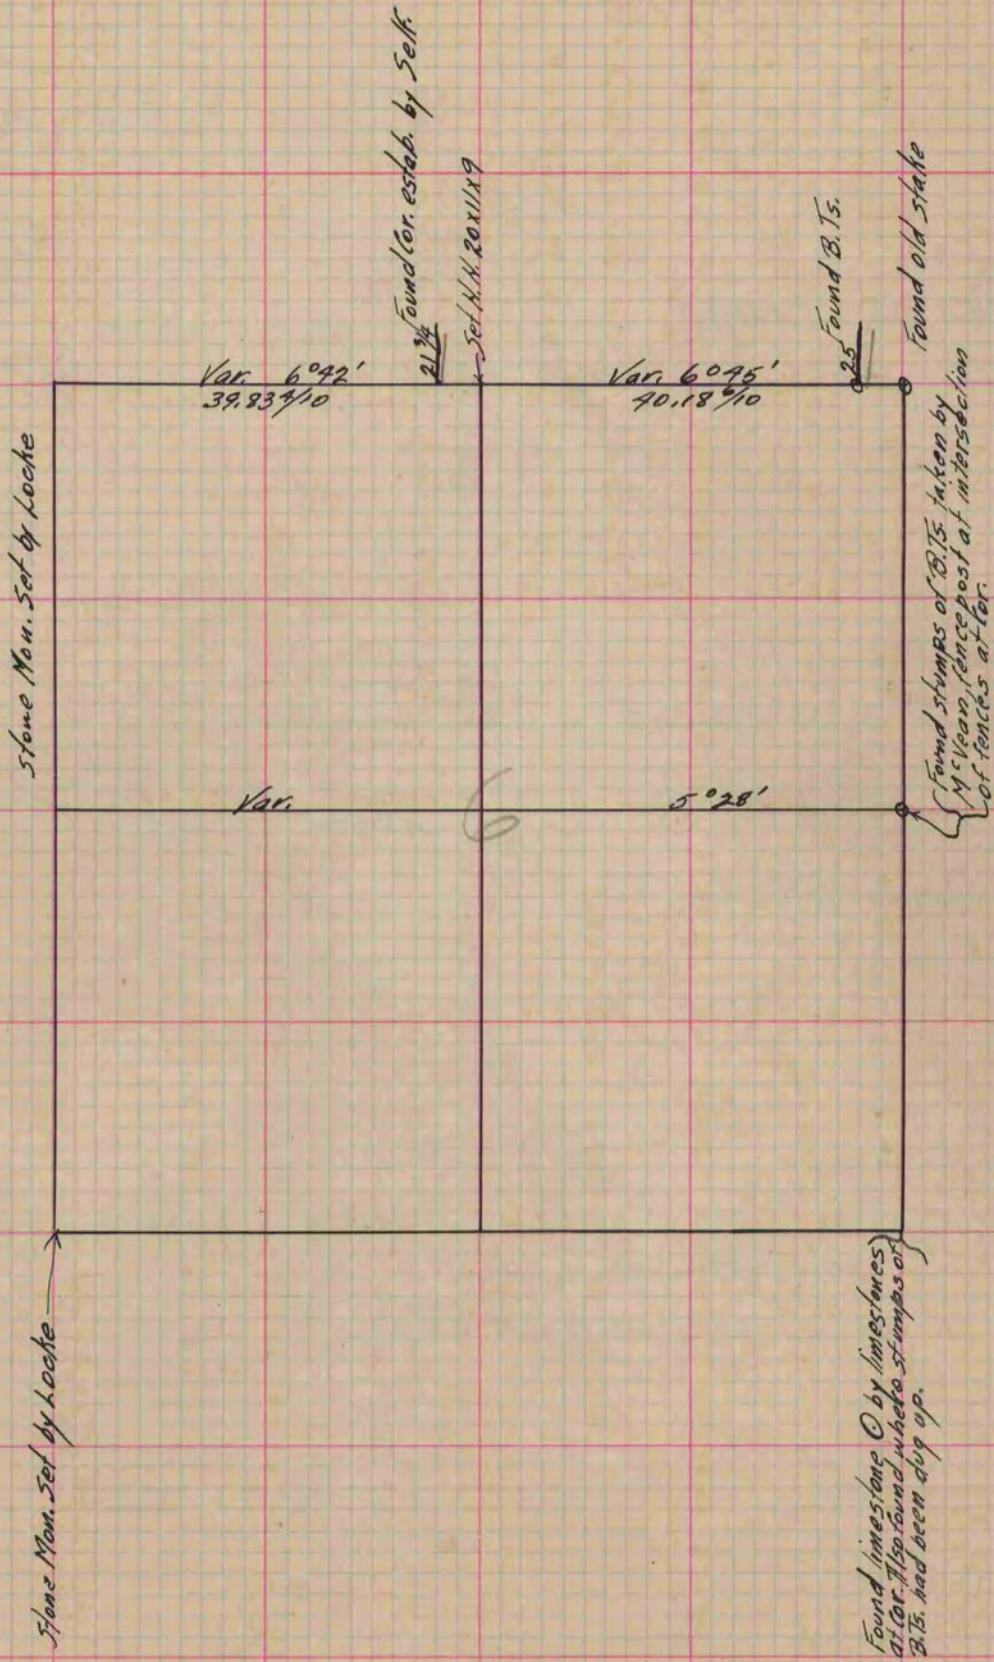

Copied from Page 29 Vol. 2 Original County Surveyor's Record.