

PLAT AND RECORD

Of a Survey on Section 30 T 3 R 11 E. of the 4 P. M. in Centre Township


Rock County, Wisconsin, made July the 7th 1870

I hereby certify that the following is a correct record of said survey as made by me.

COUNTY BUILDING
IN CITY OF БЕЛОIT

(Signed) Edward Ruger
R. H. B.

County Surveyor.

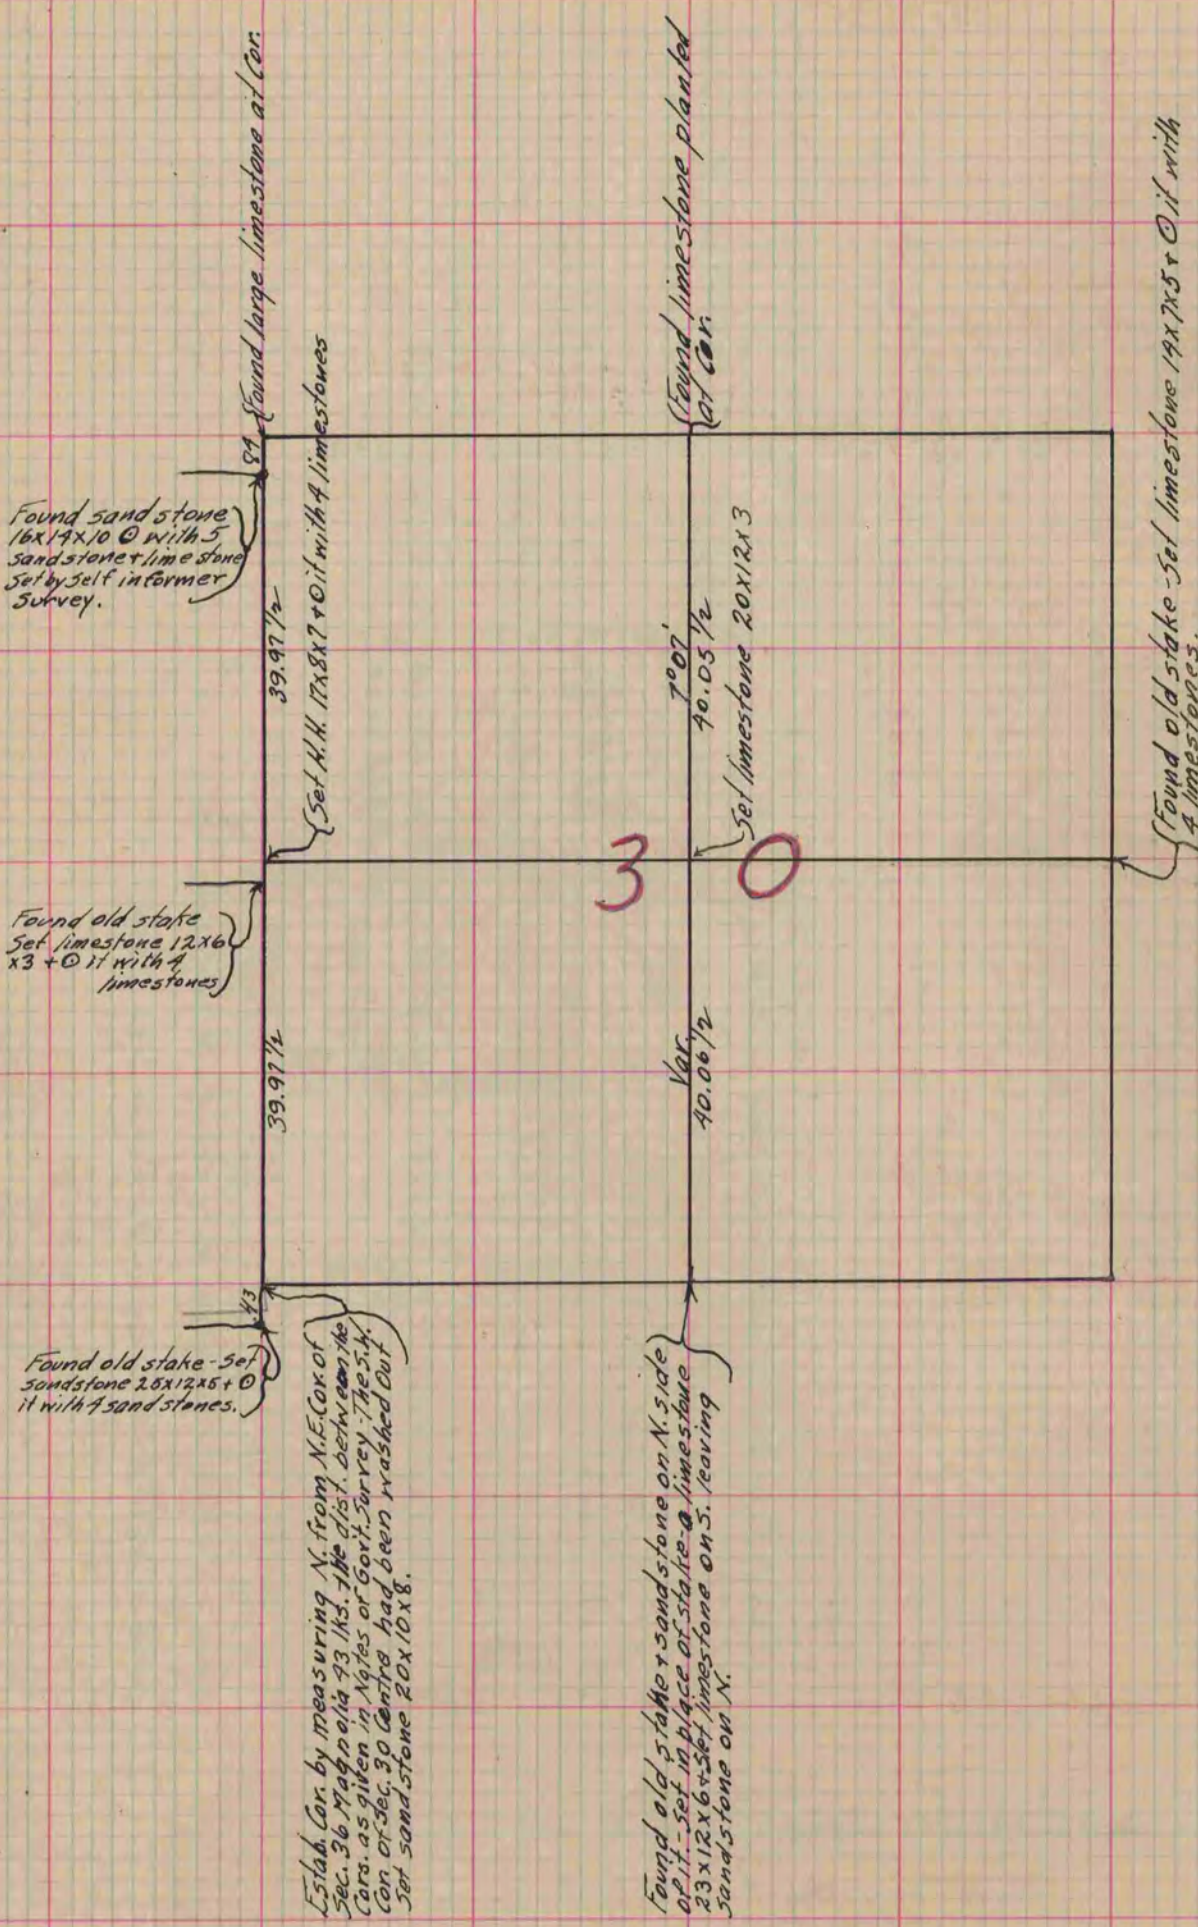

Copied from Page 25 Vol. 2. Original County Surveyor's Record.