

# PLAT AND RECORD


Of a Survey on Section 14 T. 1 N. R. 10 E. of the 4 P. M. in AVON Township

Rock County, Wisconsin, made DECEMBER the 13<sup>th</sup> 1974


I hereby certify that the following is a correct record of said survey as made by me.

COUNTY BUILDING  
IN CITY OF БЕЛОIT

*Hugh J. Lee*  
County Surveyor.

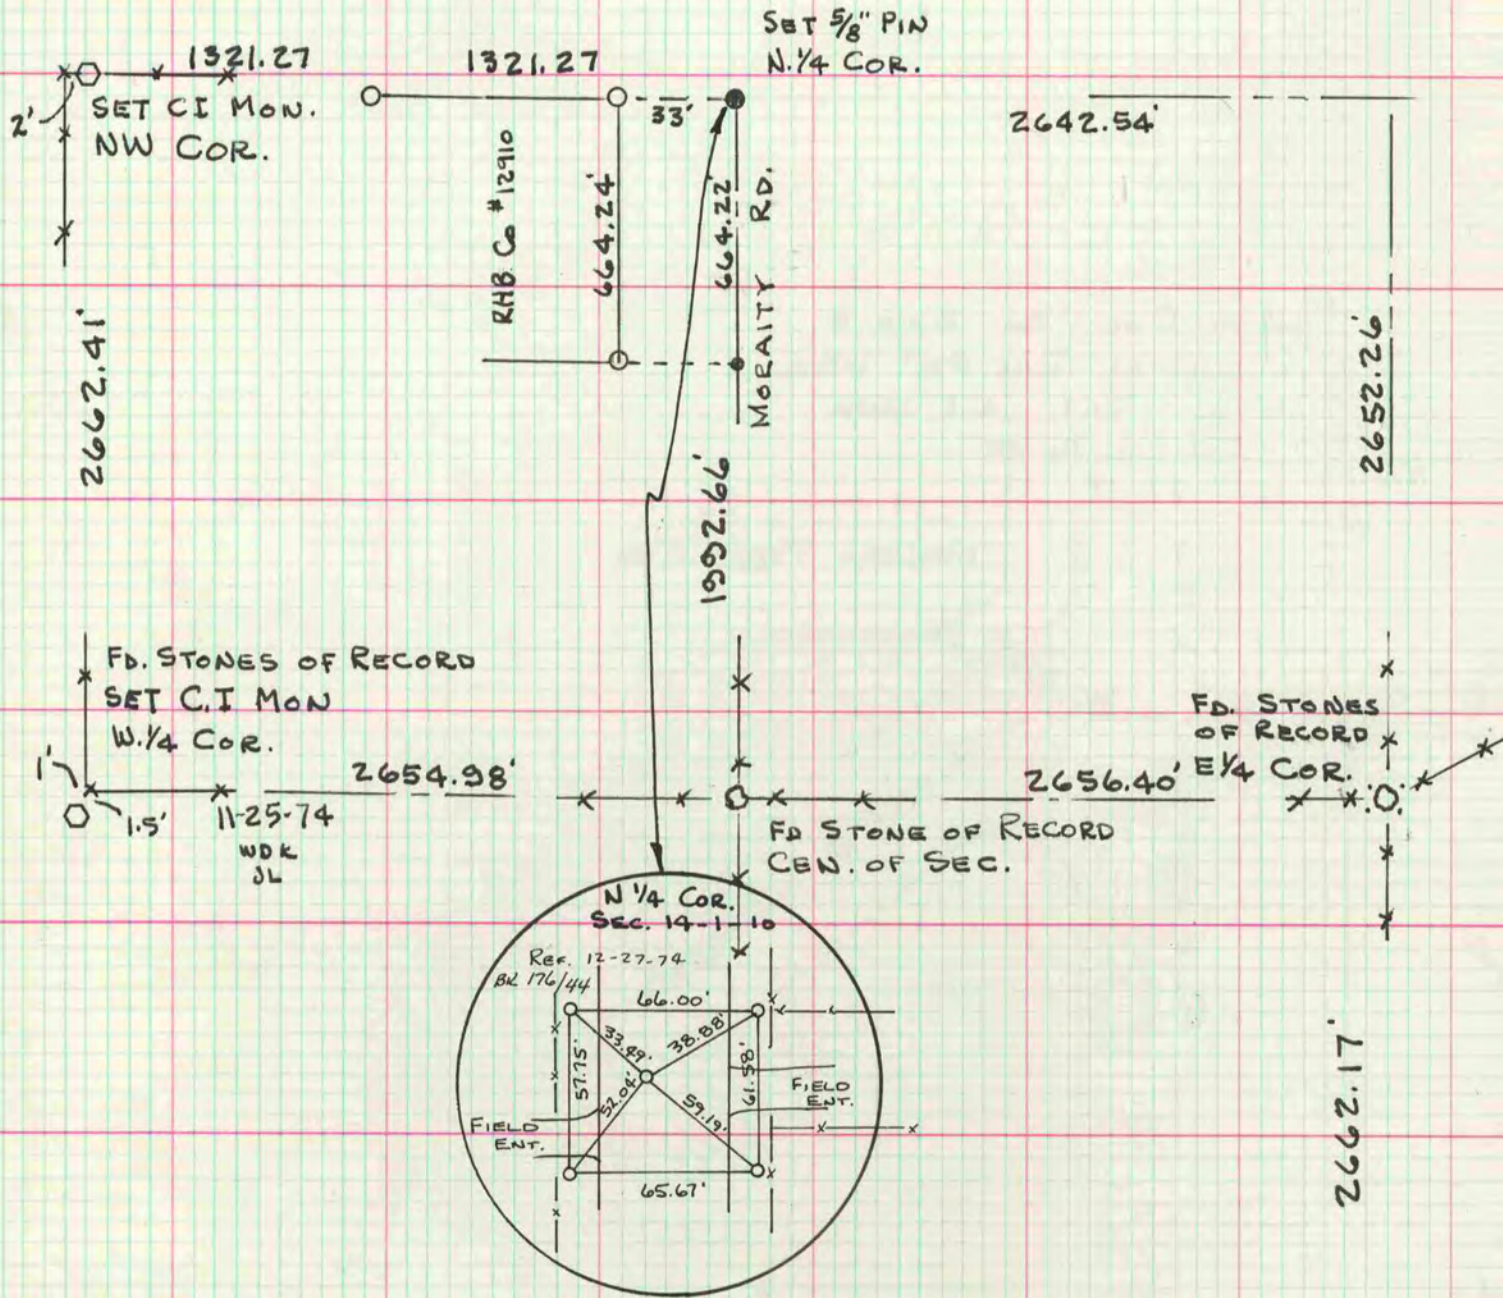

NEWARK RD.

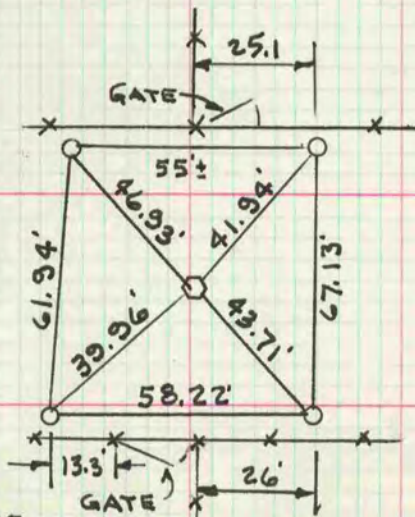

SW COR & S 1/4 COR  
SEC 14-1-10  
DUG & FO NOTHING

8-8-72  
SET CI MON.  
S.E. COR. \* DUG & FD.  
STAKE O BY 3 HH's