

U.S. PUBLIC LAND SURVEY MONUMENT RECORD

For Public Land Survey Corners in the


T. 3 N., R. 10 E.

CORNER CODE INDEX

	1	2	3	4	5	6	7	8	9	10	11	12	13	14	15	16	17	18	19	20	21	22	23	24	25
A																									
B																									
C	6																								
D		5																							
E			4																						
F				3																					
G					2																				
H																									
I	7																								
J		8																							
K			9																						
L				10																					
M					11																				
N						12																			
O							13																		
P								14																	
Q									15																
R										16															
S											17														
T												18													
U													19												
V														20											
W															21										
X																22									
Y																	23								
Z																		24							
																			25						
																				26					
																					27				
																						28			
																							29		
																								30	
																									31
																									32
																									33
																									34
																									35
																									36

PLACE MONUMENT SYMBOL (◆) AT PROPER LOCATION ON ABOVE INDEX

EXAMPLE

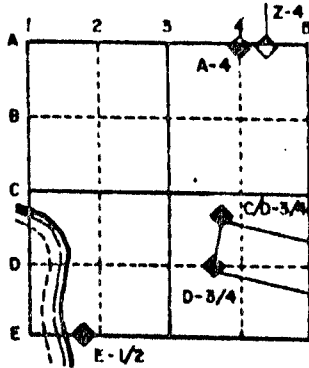

MAGNOLIA TWP
ROCK COUNTY WI

IF AVAILABLE STATE PLANE COORDINATES


North (Y) _____ Eleve. (Z) _____
 East (X) _____ Zone _____
 Hor. Datum _____ Vert. Datum _____

c.)

◆ CORNER MONUMENT

○ WITNESS MONUMENT

BEARINGS ARE BASED ON: ASSUMED

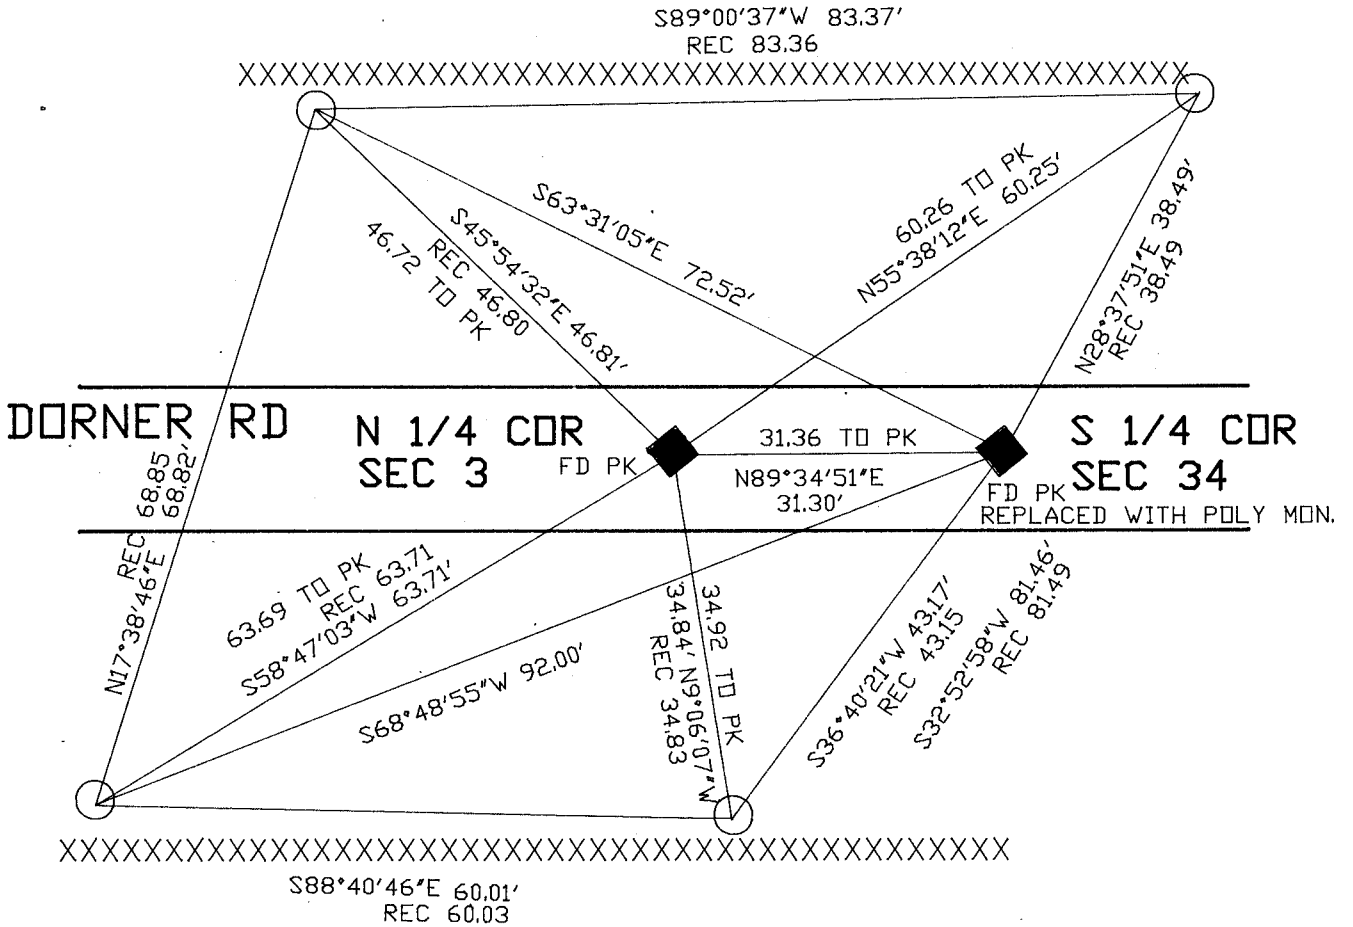

SPRING VALLEY FIELD BOOK #3 PG 27, 34

○ FOUND 1' PIPE

MICROFILMED

SHEET ___ OF ___

CORNER CODE: Z 15

(B) Describe any record evidence, monument evidence, occupational evidence, testimonial evidence or any other material evidence you considered, and whether the monument was found or placed.

18 ORIG SET QUARTER SECTION POST IN PRAIRIE & MADE A MOUND
1874 RUGER VOL 2 PG 134 FOUND OLD STAKE DEEP IN GROUND & LIMESTONE ON TOP OF IT. SET LIMESTONE 20X7X6 SURROUNDED 4 HH. SHOWS IT 31.84 OF N 1/4 CORNER OF SECTION SEC 3. SHOWS 2651.22 TO CENTER OF SECTION 34 AND 2631.64 TO SW CORNER OF SECTION 34.

1965 BATTERMAN JR. VOL 4 PG 213. FOUND SANDSTONE 5X4 SITTING ON END SURROUNDED BY LIMESTONE. N 1/4 CORNER OF SECTION 3 IS WEST. FOUND 7X6 LIMESTONE SITTING ON HH AT N 1/4 CORNER OF SECTION 3. REFERENCED CORNERS.

1988 BARNES VOL 6 PG 391 SHOWS ABOVE RECORD DISTANCES.

FOUND PK AND REFERENCE TIES. REPLACED PK WITH POLY MONUMET.

C) Was the corner restored through acceptance of (1) an obliterated evidence location, or, (2) a found perpetuated location?


ACCEPTED FOUND PK. IT AGREED WITH THE REFERENCE PIPES.

D) Describe any material discrepancy between the location of the corner as restored or reestablished and the location of that corner as previously restored or reestablished by distance and direction. Show the discrepancy on the plan view drawing under (a), above. Show the distances between the corner as previously restored or reestablished and (1) the corner as restored or reestablished, and (2) to at least 4 of the witness monuments shown on the drawing in (a), above.

(E) Was the corner reestablished through lost corner proportionate methods? If so, show the method, including the directions and distances to other public land survey corners used as evidence or used for proportioning the corner location.

I, Donald Barnes, hereby certify that the corner points as identified by the corner code index were, in a field survey on, September 11, 1990, established, re-established, monumented, re-monumented, recovered or restored as expressed below and in conformance with the regulations and rules as required in the current manual of survey instructions of the United States Department of Interior, Bureau of Land Management.

Donald Barnes
seal

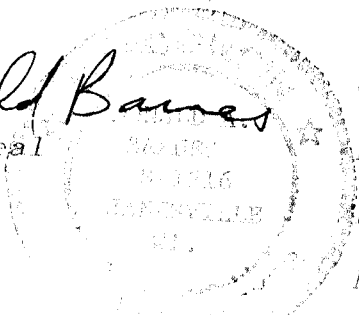

COUNTY SURVEYOR FILING DATA

Date of computer entry _____

Date microfilmed _____

Number of included sheets _____

CORNER CODE

215

AFFIX YOUR LAND SURVEYOR SEAL