
PUBLIC LAND U.S. SURVEY MONUMENT RECORD

For Public Land Survey Corners in: T.3 N., R. 0 E

WI ADMINISTRATIVE CODE A-E 7.08 REQUIREMENT

CORNER CODE INDEX

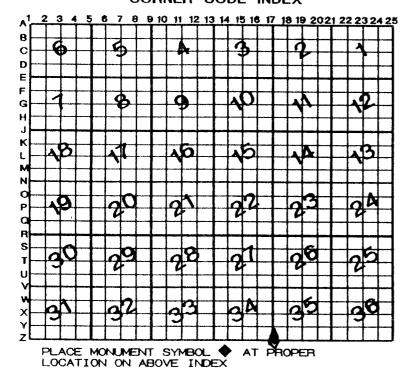

MAG	TWI	
ROCK	COUNTY	WI

IF AVAILABLE ROCK COUNTY COORDINATES PERFERRED

North	Elev
East	
Hor. Datum	Vert. Datum
LATITUDE	ELLIPS. H
LONGITUTE	
GPS (X)	TRAVERSE (X)
BASED ON THE	FOLLOWING CONTROL:

♦CORNER MONUMENT

WITNESS MONUMENT

BEARINGS ARE BASED ON:

(a)

			/
FIELD BOOKPAGE #	SHEET	OF	
SHOW A PLAN VIEW DRAWING DEPICTING THE CORNER MONUMENT AND			•
PHYSICAL FEATURES, INCLUDING THE EXCAVATION AREA AND DEPTH.	Johns	ONDING	
PLANNING & ZONING COMMITTEE ADOPTED THE ABOVE FORM ON 12/2/1982			
TEARING & ZONING COMMITTEE ADOPTED THE ABOVE FORM ON 12/2/1982		_	

MA629

- (B) Describe any record evidence, monument evidence, occupational evidence, testimonial evidence or any other material evidence you considered, and whether the monument was found or placed.
- 1834 ORIG SET POST CORNER SECTION 34 & 35. BUR OAK 12 N22W 99 WHITE OAK 14 N62E 215.16
- 1834 MILLER ORIGINAL FIELD NOTES. INTERSECTED NORTH BOUNDARY 9.9' EAST OF POST. SET POST IN MOUND CORNER OF SECTION 2 & 3.
- 1858 CHURCH VOL 1 PG 84 SHOWS 2601.72 TO S 1/4 CORNER OF SECTION 35.
- 1881 LEE VOL 2 PG 335 FOUND OLD STAKE NEAR CENTER OF ROAD & 9.9' W
 OF LINE OF FENCE TO SOUTH SET A LIMESTONE 16X6X6 POINT UP.
 9.9' WEST OF NE CORNER OF SECTION 3. SHOWS 2632.74 TO S 1/4
 CORNER OF SECTION 35. SHOWS THAT THE S 1/4 CORNER OF
 SECTION 35 IS ON A STRAIGHT LINE AND MID WAY BETWEEN THE SW
 AND SE CORNERS OF SECTION 35.
- 1929 BATTERMAN VOL 3 PG 163 CORNER GONE. SHOWS 10' TO NE CORNER OF SECTION 3
- 1929 BATTERMAN VOL 3 PG 159 SHOWS NE CORNER OF SECTION 3 10'
 FROM EDGE OF CONCRETE PAVEMENT. STATES THAT THE NE CORNER
 OF SECTION 3 WAS DISTURBED. 1967 NOTE STATES THAT A R/R WAS
 REPLACED AT THE NE CORNER OF SECTION 3. REFERENCED THE NE
 CORNER OF SECTION 3. TIES SHOW THAT THE NE CORNER OF
 SECTION 3 IS 9.8' EAST OF THE CENTER OF THE PAVEMENT.
- 1967 BATTERMAN JR. VOL 4 PG 336 CORNER GONE. SEE VOL 3 PG 145. NE CORNER OF SECTION 3 RESET FROM VOL 3 PG 176.
- 1988 BARNES VOL 6 PG 391. SHOWS THE FOLLOWING JOG DISTANCES LEE 1881 9.90'

DRIGINAL 9.90'

ALSO SHOWS THAT THE CORNER IS WEST OF THE SPRING VALLEY CORNER.

1988 BARNES VOL 6 PG 390 SHOWS JOG DISTANCES.

FOUND REFERENCE PIPES FOR NE COR SEC 3 SPRING VALLEY. PAVEMENT WILL BE GROUND OUT & REPAVED. DID NOT EXCAVATE FOR MONUMENT BECAUSE OF THE FOLLOWING: BATTERMAN VOL 4 PG 336 STATES CORNER GONE. NW & SW INTERSECTION INDICATES ROAD CUT, NE INTERSECTION INDICATES FILL, & SE INTERSECTION INDICATES POSSIBLE CUT.

C) Was the corner restored through acceptance of (1) an obliterated evidence location, or, (2) a found perpetuated location?

DID NOT ESTABLISH CORNER.

Unical Backs May 15, 2000

- D) Describe any material discrepancy between the location of the corner as restored or reestablished and the location of that corner as previously restored or reestablished by distance and direction. Show the discrepancy on the plan view drawing under (a), above. Show the distances between the corner as previously restored or reestablished and (1) the corner as restored or reestablished, and (2) to at least 4 of the witness monuments shown on the drawing in (a), above.
- (E) Was the corner reestablished through lost corner proportionate methods? If so, show the method, including the directions and distances to other public land survey corners used as evidence or used for proportioning the corner location.

I, Donald Barnes, hereby certify that the corner points as identified by the corner code index were, in a field survey on, Mag 7000, established, re-established, monumented, recovered or restored as expressed below and in conformance with the regulations and rules as required in the current manual of survey instructions of the United States Department of Interior, Bureau of Land Management.

COUNTY SURVEYOR FILING DATA

Date of computer entry

Date microfilmed

Number of included sheets 1

CORNER CODE Z-17