

(b.) Describe any record evidence, monument evidence, occupational evidence, testimonial evidence or any other material evidence you considered, and whether the monument was found or placed.

SEE SHEET 2



(c.) Was the corner restored through acceptance of (1) an obliterated evidence location, or, (2) a found perpetuated location?

SEE SHEET 2

(d.) Describe any material discrepancy between the location of the corner as restored or reestablished and the location of that corner as previously restored or reestablished by distance and direction. Show the discrepancy on the plan view drawing under (d), above. Show the distances between the corner as previously restored or reestablished and (1) the corner as restored or reestablished, and (2) to at least 4 of the witness monuments shown on the drawing in (d), above.

(e.) Was the corner reestablished through lost corner proportionate methods? If so, show the method, including the directions and distances to other public land survey corners used as evidence or used for proportioning in determining the corner location.

I, Donald Barnes, hereby certify that the corner points as identified by the corner code index were, in a field survey on Dec 7 1988, established, re-established, monumented, re-monumented, recovered or restored as expressed below and in conformance with the regulations and rules as required in the current manual of survey instructions of the United States Department of Interior, Bureau of Land Management.

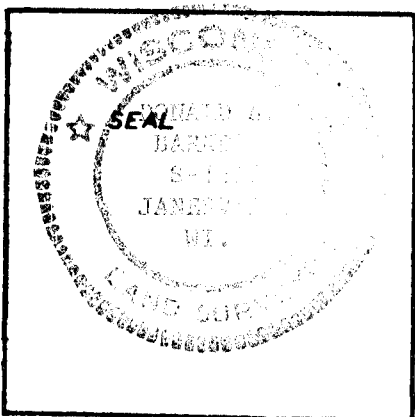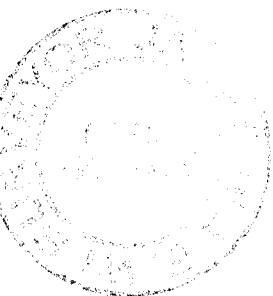

COUNTY SURVEYOR FILING DATA

Date of Computer Entry _____

Date Received _____

Date Microfilmed _____

Treasurer's Receipt No. _____

Number of Included Sheets 1

AFFIX YOUR LAND SURVEYOR SEAL.

CORNER CODE V19

(B) Describe any record evidence, monument evidence, occupational evidence, testimonial evidence or any other material evidence you considered, and whether the monument was found or placed.

1858 CHURCH VOL 1 PG 84 USED CORNER TO SUBDIVIDE SECTION 35.
STATES NOTHING ABOUT CORNER.

1868 LOCKE VOL 1 PG 326 FOUND HH SURROUNDED BY 4 OR 5 LIMESTONES.
SET STAKE WITH HARDHEAD ON N & S AND LIMESTONES ON E & W IN
CENTER OF HIGHWAY & IN LINE WITH N/S FENCE.

1881 LEE VOL 2 PG 335 COULD NOT FIND STAKE & STONES SET BY LOCKE,
BUT FOUND STAKE SET BY HIM AT CENTER OF NORTH LINE OF NE
QUARTER. ESTABLISHED QUARTER CORNER FROM THIS AND NE
CORNER.

1967 BATTERMAN VOL 4 PG 336 DUG AND FOUND NOTHING.

DUG 7' DEEP AND FOUND NOTHING.

C) Was the corner restored through acceptance of (1) an
obliterated evidence location, or, (2) a found perpetuated
location?

LOCKE'S VARIANCE SHOWS THAT THE SOUTH QUARTER CORNER IS NOT ON
LINE WITH THE SOUTH EAST AND SOUTH WEST CORNERS OF SECTION 26.
I PRORATED LOCKE'S DISTANCE WITH THE DISTANCE THAT I MEASURED
FROM THE SOUTH WEST CORNER OF SECTION 26 AND THE SOUTH 1/16th
CORNER OF THE SOUTH EAST QUARTER OF SECTION 26. LOCKE STATED
THAT THE CORNER IS IN THE CENTER OF THE ROAD. BASED ON THIS, I
USED THE CENTER OF THE ROAD TO CONTROL THE N/S DIRECTION. THIS IS
ALSO IN HARMONY WITH LEE'S DISTANCE TO THE EAST WEST QUARTER LINE
OF SECTION 35.

Donald Barnes
Dec 2 1988

