

U.S. PUBLIC LAND SURVEY MONUMENT RECORD

For Public Land Survey Corners In:

WI ADMINISTRATIVE CODE A-E 7.08 REQUIREMENT

T. 2N. R. 11E.

CORNER CODE INDEX

PLYMOUTH TWP

ROCK COUNTY WI

IF AVAILABLE

ROCK COUNTY COORDINATES PREFERRED

1	2	3	4	5	6	7	8	9	10	11	12	13	14	15	16	17	18	19	20	21	22	23	24	25	
A																									A
B																									B
C																									C
D																									D
E																									E
F																									F
G																									G
H																									H
I																									I
J																									J
K																									K
L																									L
M																									M
N																									N
O																									O
P																									P
Q																									Q
R																									R
S																									S
T																									T
U																									U
V																									V
W																									W
X																									X
Y																									Y
Z																									Z

North _____ Elev. _____

East _____

Hor. Datum _____ Vert. Datum _____

LATITUDE _____ ELLIPS. HT. _____

LONGITUDE _____

GPS (X) _____ TRAVERSE (X) _____

BASED ON THE FOLLOWING CONTROL:

1 2 3 4 5 6 7 8 9 10 11 12 13 14 15 16 17 18 19 20 21 22 23 24 25
PLACE MONUMENT SYMBOL AT PROPER LOCATION ON ABOVE INDEX

CORNER MONUMENT

WITNESS MONUMENT

(a)

BEARINGS ARE BASED ON: _____

FIELD BOOK _____ PAGE # _____

SHEET 1 OF 3

SHOW A PLAN VIEW DRAWING DEPICTING THE CORNER MONUMENT AND SURROUNDING PHYSICAL FEATURES, INCLUDING THE EXCAVATION AREA AND DEPTH.

PLANNING & ZONING COMMITTEE ADOPTED THE ABOVE FORM ON 12/2/1982

CORNER CODE J-7

PL544

(B) Describe any record evidence, monument evidence, occupational evidence, testimonial evidence or any other material evidence you considered, and whether the monument was found or placed.

- 1833 HARRISON EAST BET 8 & 17 ON RAND
2640 TEMPY ¼ P
3234 LEFT MARSH & ENTER TIM
5291.88 INT. E BDY 12.54' N OF P LEVEL 1^{BT} ½ MILE SAME
LAST ½ ROLLING 2ND RATE WITH BURR O TIMBER
COR WEST
2645.94 QUARTER SEC COR {BURR O 12 S 14E 373.56'
BURR O 20 S 5E 395.34' BURR O 12 BURR O
10} MARKED
5291.88 SEC COR
- 1858 CHURCH VOL 1 PG 76 GOV. QR. POST. VAR 6 2624.16 TO
SE COR SEC 8, VAR 7-1/2 2661.12 TO CENTER SEC 8, &
5322.24 TO N ¼ COR SEC 8
- 1862 CHURCH TWP RD REC BK 1 PG 43 COMMENCING AT THE SEC
COR BETWEEN SEC 9 & 10 ON THE NORTH LINE OF SAID
SECTIONS AND RUNNING THENCE SOUTH ON SEC LINE TO
SOUTH LINE OF SAID SEC; THENCE WEST ON SEC LINE TO
THE SW COR OF SEC 8.
- 1867 TWP RD REC BK 1 PG 54 COMMENCING AT THE SE COR OF
SEC 8 AND RUNNING NORTH ON THE SECTION LINE BETWEEN
SEC 8 & 9 TO THE NE COR OF SEC 8 THENCE IN A
NORTHERLY DIRECTION TO A PT 33' EAST OF THE SE COR OF
THE NE ¼ OF THE SE ¼ OF SEC 5 THENCE NORTH ON THE
EAST SIDE OF THE SECTION LINE BETWEEN SECTIONS 4 & 5
TO THE QUARTER POST ON SAID SEC. LINE, OR TO
INTERSECT WITH RD RUNNING SOUTH FROM FOOTVILLE. THE
LINE OF SAID SURVEY TO BE THE CENTER OF SAID HWY, AND
THE SAME IS ESTABLISHED 66' IN WIDTH.
- 1868 LOCKE PG B3 EAST BETWEEN SECS 8 AND 17 VAR 6-15
O SET OFF 46.86' SOUTH
1369.5 FENCE RUNNING NORTH
2661.12 INTERSECTED ¼ LINE AT COR. FOUND B.TS EAST
BT IS S 16E AND WEST BT IS 395.34' DIST. COR
2.97' SOUTH OF E & W FENCE AND 26.07' WEST OF
FENCE RUNNING NORTH AND NEAR THE END OF A
SOD FENCE RUNNING WEST VAR CORRECTED 5-14
CONTINUED EAST FROM ¼ COR WITH VAR 6-35
5313.33 INTERSECTED EAST BOUNDARY 11.22' NORTH OF
COR. VAR CORRECTED 6-20 SEPT 16. 1868
- 1869 RUGER VOL 2 PG 10 STONE MON SET BY LOCKE 2645.94 TO SE
COR SEC 8
- 1873 RUGER VOL 2 PG 121 STONE MON VAR 5-45 2645.61 TO NE COR
SEC 17 & VAR 6-20 2633.4 TO CENTER SEC 17
- 1978 BARNES VOL 5 PG 480 2' DEEP FD CUT LIMESTONE. LAYING ON
ITS SIDE. AREA HAD BEEN BULLDOZED. REFERENCED CORNER
L.S.
- 1978 BARNES VOL 5 PG 501 S 89-22-55E 2652.79 TO SE COR SEC 8,
N 88-22-07W 2661.70 TO SW COR SEC 8, N 0-28-37W 2677.29 TO
CENTER SEC 8, N 0-30-01W 2661.12 FROM CENTER SEC 8 TO N ¼
COR SEC 8, & S 0-19-46E 2640.22 TO CENTER SEC 17
- 1978 BARNES VOL 5 PG 503 THE CORNER WAS ESTABLISHED BY
PRORATING LOCKE'S 1868 REMONUMENTATION DISTANCE FROM
THE SW & SE CORNERS SEC 8 & PRORATING RUGER'S 1873
DISTANCE FROM THE CENTER SEC 17 AS ESTABLISHED BY
PRORATING RUGER'S E/W CENTERLINE FROM E ¼ COR SEC 17.
SET ALUM. MON IS 1.51' EAST & 0.12' SOUTH OF FD STONE
SEE PG 480. REFERENCED SAME
- 1990 BARNES VOL 6 PG 409 SOUTH LINE OF SE ¼ SEC 8 SHOULD BE
S 89-22-55E 2652.79
- 1999 KREBS VOL 6 PG 455 5333.09 TO S ¼ COR SEC 17 & 2663.84
TO CENTER SEC 17.
- 2000 BARNES VOL 6 PG 455 N 88-22-11W 2661.68 TO SW COR SEC 8,
S 89-22-55E 2652.79 TO SE COR SEC 8, N 0-28-37W 2677.26 TO
CENTER SEC 8, N 0-30-02W 2669.83 FROM CENTER SEC 8 TO N ¼
COR SEC 8, & S 0-22-22E 5310.21 TO S ¼ COR SEC 17.

Ronald Barnes

1-2-03

PL544

AREA DISTURBED BY FARMER. COUNTY BACK HOE DUG A LARGE HOLE AND FD LARGE TREES AND OTHER DEBRIS 5' DEEP. FD A PIECE OF THE ALUM. MON LAYING ABOUT 30' NORTH. USED MY OLD OBSERVATIONS TO DETERMINE POSITION. PLACED POLY. MON 1.2' DEEP.

C) Was the corner restored through acceptance of (1) an obliterated evidence location, or, (2) a found perpetuated location?

RESTORED THROUGH ACCEPTANCE OF OBLITERATED EVIDENCE LOCATION.

D) Describe any material discrepancy between the location of the corner as restored or reestablished and the location of that corner as previously restored or reestablished by distance and direction. Show the discrepancy on the plan view drawing under (a), above. Show the distances between the corner as previously restored or reestablished and (1) the corner as restored or reestablished, and (2) to at least 4 of the witness monuments shown on the drawing in (a), above.

(E) Was the corner reestablished through lost corner proportionate methods? If so, show the method, including the directions and distances to other public land survey corners used as evidence or used for proportioning the corner location.

I, Donald Barnes, hereby certify that the corner location as identified by the corner code index was determined by me under my direction and control and that this U.S. Public Land Survey Monument Record is correct and complete to the best of my knowledge and belief.

Seal

Donald Barnes


Emboss

1/02/03

SHEET 2 OF 3

CORNER CODE **J-7**

A.E. 7.08 REQUIREMENT

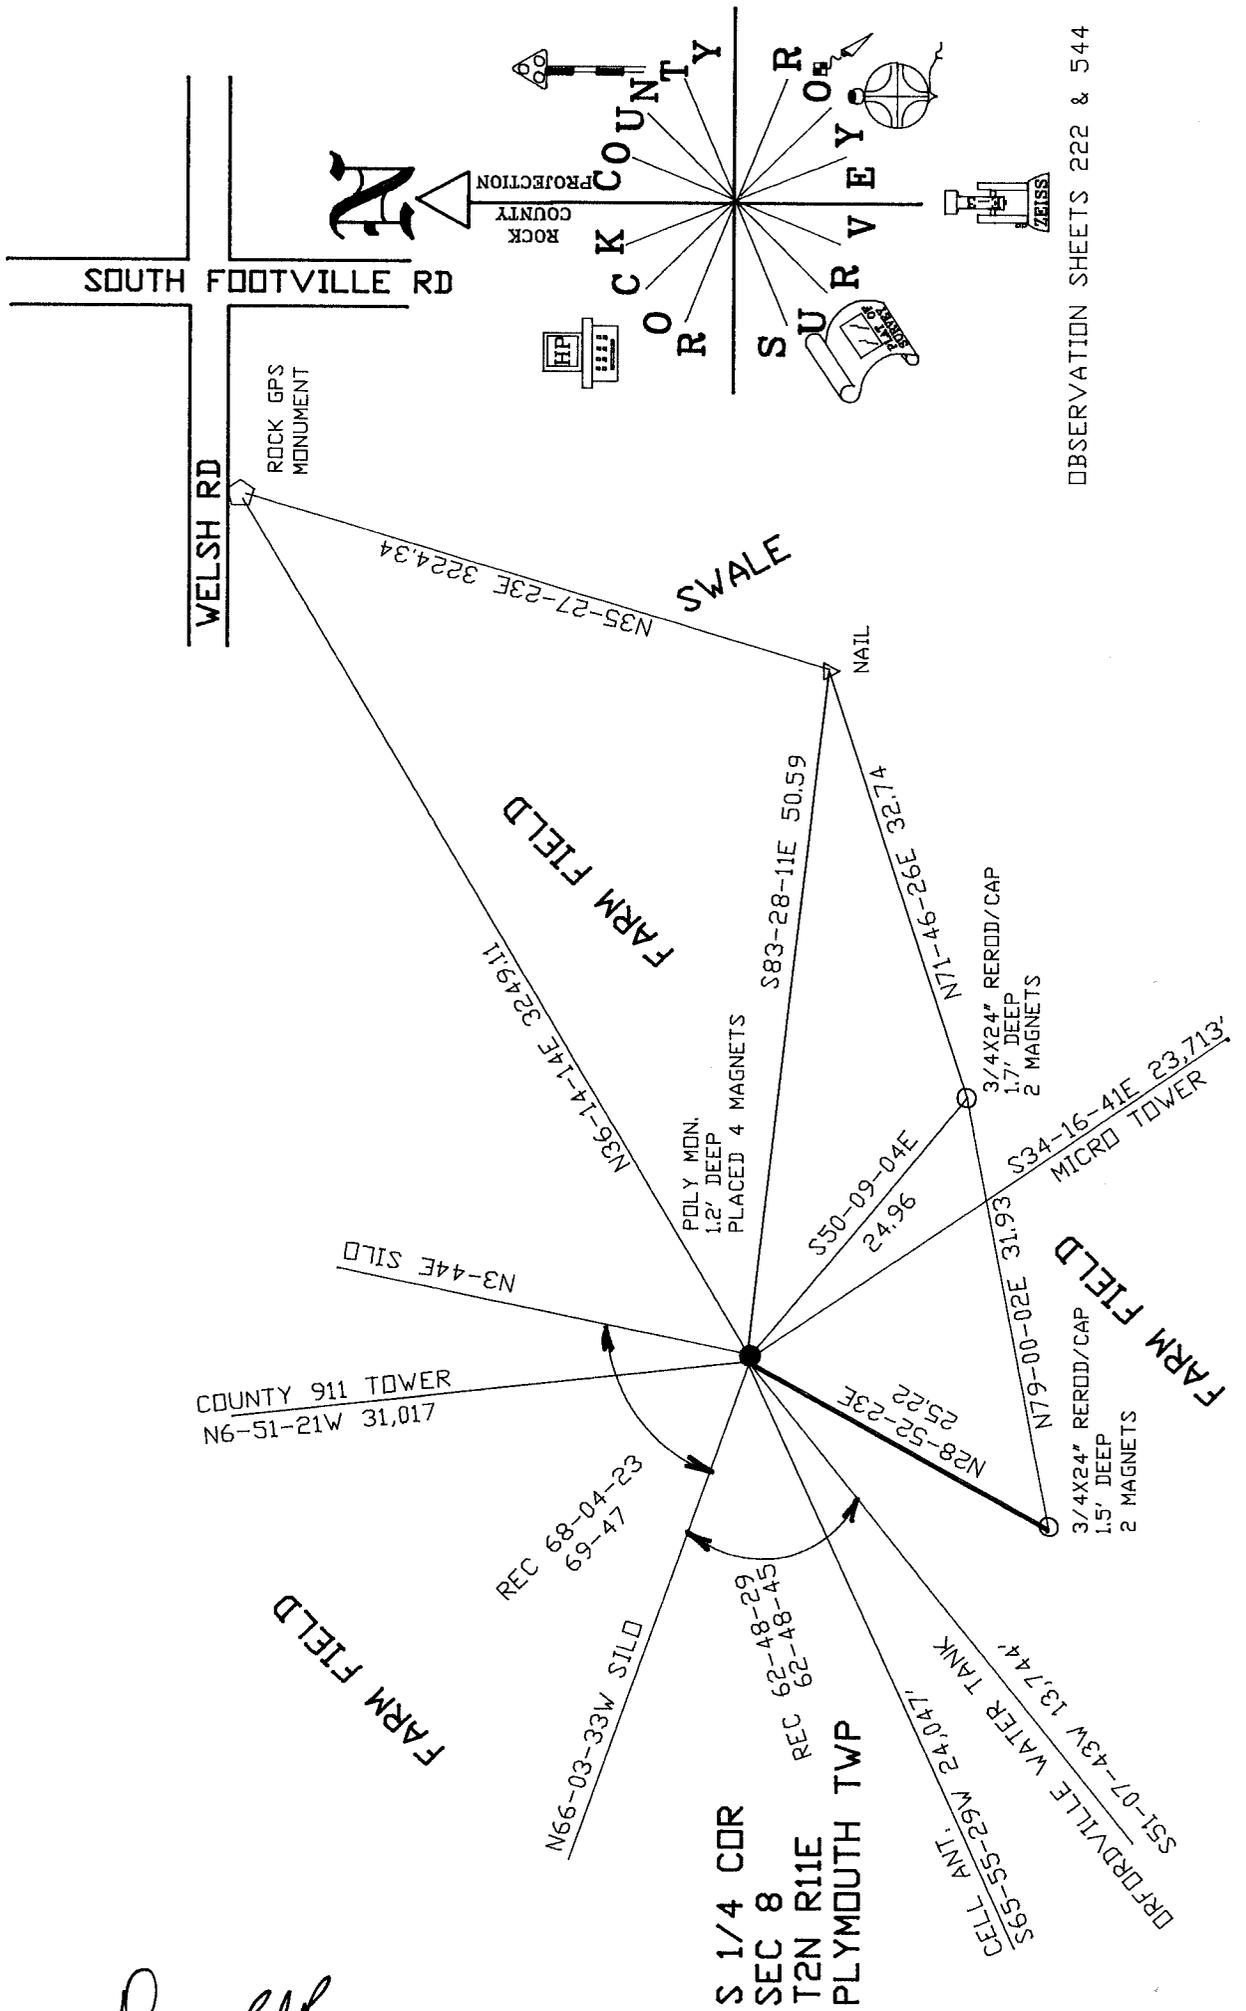

OBSERVATION SHEETS 222 & 544

Donald Barnes
 EMBOSSED
 SEAL
 1/02/03

57