U.S.


(a)

## PUBLIC LAND SURVEY MONUMENT RECORD

For Public Land Survey Corners in: T. 2N., R. // E

WI ADMINISTRATIVE CODE A-E 7.08 REQUIREMENT

CORNER CODE INDEX

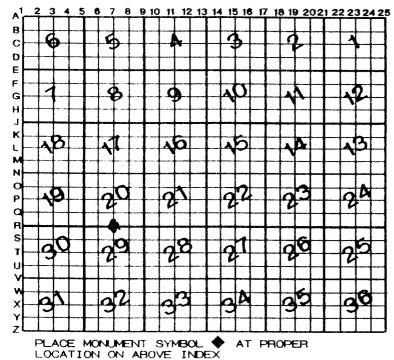

PLY MOUTH TWP ROCK COUNTY WI

IF AVAILABLE ROCK COUNTY COORDINATES PERFERRED

North Elev. East Hor. Datum \_\_\_\_\_ Vert. Datum ELLIPS. HT. LATITUDE LONGITUTE GPS (X) \_\_\_ TRAVERSE (X) \_\_\_ BASED ON THE FOLLOWING CONTROL:

**♦** CORNER MONUMENT

O WITNESS MONUMENT

ORPOPPULLE GPS AZM. # 307A BEARINGS ARE BASED ON

LIS N89-23-34W SW SOR 2659,63 514 SEC 70 Sec 20

St COR SEC ZO

38, 58. 38, 0 38, 29, ALUM E14-29

OBSERVATION SHEET 264

\_\_PAGE # \_ FIELD BOOK \_\_\_

SHEET  $\bot$  OF 2

SHOW A PLAN VIEW DRAWING DEPICTING THE CORNER MONUMENT AND SURROUNDING PHYSICAL FEATURES, INCLUDING THE EXCAVATION AREA AND DEPTH.

PLANNING & ZONING COMMITTEE ADOPTED THE ABOVE FORM ON 12/2/1982

## PL584

(B) Describe any record evidence, monument evidence, occupational evidence, testimonial evidence or any other material evidence you considered, and whether the monument was found or placed.

1833 HARRISON EAST ON RAND. BET 20 & 29

2640 QUARTER SEC COR (TEMPY)

5301.12 INT. E BDY AT POST LAND HIGH ROLLING 1<sup>ST</sup> RATE PRAIRIE ? GRASS & WEEDS

COR WEST

2650.56 SET QUARTER SEC COR POST & RAISED MOUND 5301.12 INT. W. BDY

- 1844 TWP RD REC BK 1 PG 3 COMMENCING AT THE NE COR OF THE W ½ DF THE NW ¼ DF SEC 26 T2N R11E IN SAID TOWN NEAR THE HOUSE OF WALTER INMAN AND RUNNING WEST ON THE LINE BETWEEN SECTIONS 23 & 26, 1325.28 TO THE COR SECTIONS 22,23,26, AND 27 WHITE DAK 36 INCHES BEARS N59W 64.03' N29E 1.00'; THENCE WEST ON LINE BETWEEN SECTIONS 22 AND 27, 5247' TO THE COR OF SECTION 21,22 AND 27 AND 28 SET POST IN MOUND WHERE OLD POST STOOD; THENCE WEST ON LAND BETWEEN SECTIONS 21 AND 28, 5267.46' TO COR OF SECTIONS 20,21 AND 28 AND 29, SET POST IN MOUND SIGHT OF OLD POST, THENCE WEST ON LINE BETWEEN 20 AND 29 UNTIL IT INTERSECTS THE BELOIT AND MADISON RD. SAID RD IS LAID OUT 66' WIDE OR 33' ON EACH SIDE OF THE LINE.
- 1849 TWP RD REC BK 1 PG 26 COMMENCING AT THE 1/4 STAKE BETWEEN 20 & 29 IN T2N, R11E RUNNING WEST UNTIL IT INTERSECTS THE RD LEADING FROM BELOIT TO MONROE AND THE SAME IS HEREBY DECLARED TO BE 66' ''''.
- 1867 LOCKE VOL 1 PG 286 & MAP #4375 FD L.S. SET ON COR. SET W.O. STAKE SURROUNDED BY 5 L.S. & 1 SANDSTONE. SANDSTONE ON SOUTH. VAR 6-10 2655.18 TO SW COR SEC 20, VAR 6-20 2672.34 TO SE COR SEC 20, VAR 7-17 2656.50 TO CENTER SEC 20, & VAR 17 FROM CENTER SEC 20 TO N 1/4 COR SEC 20
- 1868 LOCKE PG 74 WEST BETWEEN SECS 20 AND 29 VAR 6-05
  2677.62 INTERSECTED 1/4 LINE 8.58' NORTH OF COR. FOUND
  COR AS SET BY SELF. (SEE CO SURVEYORS RECORD
  SEC 20) IN CENTER OF OLD HIGHWAY AND 1.32' EAST
  OF LINE OF FENCE RUNNING SOUTH. VAR CORRECTED
  6-16

CONTINUED WEST FROM 1/4 COR WITH VAR 6-05

3022.8 BOTTOM OF RAVINE

5338.41 INTERSECTED WEST BOUNDARY AT COR. FOUND COR.
AS SET BY SELF. (SEE CO SURVEYORS RECORD) COR.
IN CENTER OF OLD ROAD AND IN LINE OF FENCE
RUNNING SOUTH & 1 FT E OF FENCE RUNNING NORTH.
SEPT 15, 1868

1978 BARNES VOL 5 PG 425 FD CUT L.S. 0.5' DEEP AT FENCE INT. REF SAME.

1978 BARNES VOL 5 PG 429 1339.05 TO  $1/16^{TH}$  COR THAT IS TO THE EAST. 1339.05 FROM THAT 1/16H COR TO SEC COR SEC 20 1978 BARNES VOL 5 PG 430 2678.10 TO SE COR SEC 20. 1978 LEE CSM VOL 7 PG 313 CONC. MON

2-06-03 Barnes

sheet 1 of  $\mathfrak{g}$  corner code R-7

PL584

2000 KREBS MAP #7596 & 7597 FD CUT STONE S88-53-10E 1339.62 TO HH AT  $1/16^{TH}$  COR. FROM HH TO SE COR SEC 20 S88-54-23E 1338.95

FD CUT L.S. WITH CARSONITE

C) Was the corner restored through acceptance of (1) an obliterated evidence location, or, (2) a found perpetuated location?

ACCEPTED FD GUT LIMESTONE.

- D) Describe any material discrepancy between the location of the corner as restored or reestablished and the location of that corner as previously restored or reestablished by distance and direction. Show the discrepancy on the plan view drawing under (a), above. Show the distances between the corner as previously restored or reestablished and (1) the corner as restored or reestablished, and (2) to at least 4 of the witness monuments shown on the drawing in (a), above.
- (E) Was the corner reestablished through lost corner proportionate methods? If so, show the method, including the directions and distances to other public land survey corners used as evidence or used for proportioning the corner location.
- I, Donald Barnes, hereby certify that the corner location as identified by the corner code index was determined by me under my direction and control and that this U.S. Public Land Survey Monument Record is correct and complete to the best of my knowledge and belief.

Z-06-03 Dull Barnes Finboss

SHEET 2 OF \$ 2

GORNER GODE R-7

A.E. 7.08 REQUIREMENT