
## U.S. PUBLIC LAND SURVEY MONUMENT RECORD

For Public Land Survey Corners in: T. 3N., R. 4 E

WI ADMINISTRATIVE CODE A-E 7.08 REQUIREMENT

CORNER CODE INDEX

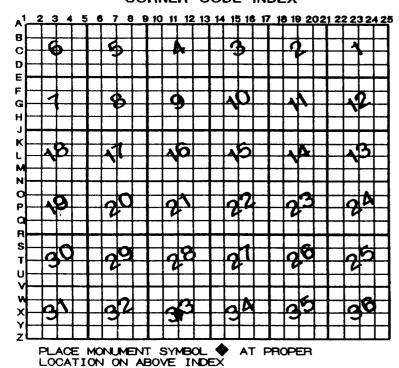

JOHN	STOWN	TWI
	COUNTY	

IF AVAILABLE ROCK COUNTY COORDINATES PERFERRED

North	Elev		
East			
Hor. Datum	Vert. Datum		
LATITUDE	ELLIPS. H		
LONGITUTE			
GPS (X)	TRAVERSE (X)		
BASED ON THE	FOLLOWING CONTROL:		

**♦**CORNER MONUMENT

O WITNESS MONUMENT

BEARINGS ARE BASED ON:

(a)

	SHEET	. (		1	
FIELD BOOKPAGE #	SHEET		OF		_
SHOW A PLAN VIEW DRAWING DEPICTING THE CORNER MONUMENT AN	D SURRO	UNDING			
PHYSICAL FEATURES, INCLUDING THE EXCAVATION AREA AND DEPTH.					
PLANNING & ZONING COMMITTEE ADOPTED THE ABOVE FORM ON 12/2/1982		,			
		V	7 1		

J08616

- (B)Describe any record evidence, monument evidence, occupational evidence, testimonial evidence or any other material evidence you considered, and whether the monument was found or placed.
- 1860 RUGER VOL 1 PG 138 SET LIMESTONE 16X10X4 (IN PENCIL WRONG) 2633.07' TO E ¼ COR & W ¼ COR SEC 33. {ESTABLISHED BY EQUAL DISTANCE METHOD ON E/W ¼ LINE}.
- 1969 BATTERMAN VOL 4 PG 410 FOUND LARGE STONE 16X10X4 1.0' DEEP AT CENTER OF SEC 33. SET MON. BOX OVER STONE. REFERENCED SAME.
- 1980 BARNES VOL 6 PG 32 FOUND MONUMENT OF RECORD. N87-29-41W 2639.93' TO E 
  4 COR SEC 33, S0-04E 2636.9X TO S 4 COR SEC 33, & N0-11-58W 2634.82' TO N 4 COR SEC 33.
- 1983 BARNES TWP PROJECT. S88-31-40E 2640.04 TO E ¼ COR SEC 33; N88-30-20W 2638.54 TO W ¼ COR SEC 33; N1-13-52W 2634.68 TO N ¼ COR SEC 33; & S1-02-46E 2635.98 TO S ¼ COR SEC 33.

FOUND PK WITH SOUNDS OF MON. BOX UNDER SAME. FOUND NE & SOUTH REFERENCE PIPES. ESTABLISHED SE AND NW REFERENCE MONUMENTS. 1' NORTH OF CENTER OF PVMT. & ON LINE WITH N/S CENTER LINE OF PVMT. MONUMENT WILL BE GROUND OUT & ROAD REPAVED.

C) Was the corner restored through acceptance of (1) an obliterated evidence location, or, (2) a found perpetuated location?

## ACCEPTED FOUND PK

- D) Describe any material discrepancy between the location of the corner as restored or reestablished and the location of that corner as previously restored or reestablished by distance and direction. Show the discrepancy on the plan view drawing under (a), above. Show the distances between the corner as previously restored or reestablished and (1) the corner as restored or reestablished, and (2) to at least 4 of the witness monuments shown on the drawing in (a), above.
- (E) Was the corner reestablished through lost corner proportionate methods? If so, show the method, including the directions and distances to other public land survey corners used as evidence or used for proportioning the corner location.
- I, Donald Barnes, hereby certify that the corner location as identified by the corner code index was determined by me under my direction and control and that this U.S. Public Land Survey Monument Record is correct and complete to the best of my knowledge and belief.

seal

T26, 2000

Number of included sheets 1

CORNER CODE X-11

**A-E 7.08 REQUIREMENT** 

