U.S.


PUBLIC LAND SURVEY MONUMENT RECORD

For Public Land Survey Corners In:

WI ADMINISTRATIVE CODE A-E 7.08 REQUIREMENT

T.Z.N. R. //_E.

CORNER CODE INDEX

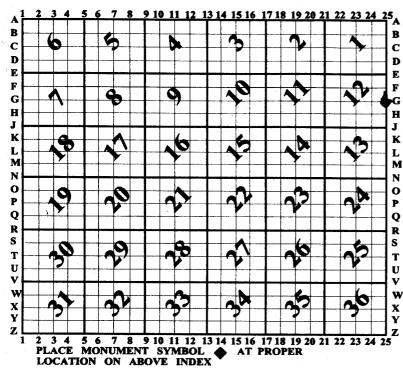

PLYMOUTH TWI

IF AVAILABLE
ROCK COUNTY COORDINATES PERFERRED

North	Elev.	
East	· ·	•
Hor. Datum	_ Vert. Da	tum
LATITUDE		_ ELLIPS. HT
LONGITUDE		
GPS (X)	TRAVERSE	(X)
BASED ON THE I	FOLLOWING	CONTROL:

♦ CORNER MONUMENT

WITNESS MONUMENT

BEARINGS ARE BASED ON:

(a)

OBSERUATION SHEETS 149, 1252, 9° 3151
FIELD BOOK _____ PAGE # _____
SHOW A PLAN VIEW DRAWING DEPICTING THE CORNER MONUMENT

SHEET _/ OF Z

SHOW A PLAN VIEW DRAWING DEPICTING THE CORNER MONUMENT AND SURROUNDING PHYSICAL FEATURES, INCLUDING THE EXCAVATION AREA AND DEPTH.
PLANNING & ZONING COMMITTEE ADOPTED THE ABOVE FORM ON 12/2/1982

PL540

(B) Describe any record evidence, monument evidence, occupational evidence, testimonial evidence or any other material evidence you considered, and whether the monument was found or placed.

1833 MULLETT ORIGINAL GOVERNMENT SURVEYOR. NORTH ON EAST SIDE SECTION 12

231 LEAVE PRAIRIE AND ENTER TIMBER

2640 SET QUARTER SECTION POST HICKORY 8 522W

17.16' HICKORY 10 N89W 16.5'

3186.48 BLACK DAK 12 IN DIAMETER

4488 ENTER MARSH

5247 SPRING STREAM ? C S.E.

5280 SET POST CORNER SECTIONS 1 & 12 BUR DAK 8
N ½ W 577.5' BUR DAK 8 S73W 256.08' LAND
ROLLING SECOND RATE TIMBER WHITE BLACK AND
BUR DAK HICKORY ?

1843 STEBING TWP RD REC BK 1 PG 1 (BUTLER RD) SURVEY OF RD IN THE TWP OF CENTER. BEGINNING AT THE 1/4 POST ON THE EAST SIDE OF SEC 12, T2N R11E; THENCE WEST 5388.24' TO 1/4 POST ON WEST SIDE OF SEC 12; THENCE NORTH 2640 TO THE NW COR OF SEC 12 OF SAID TOWN AND RANGE AND THE WHOLE LENGTH OF THE ROAD 1 1/2 MILES 108.24'. COURSE GIVEN ACCORDING TO THE TRUE MERIDIAN. VARIATION OF THE NEEDLE 7 1/2

1864 LOCKE VOL 1 PG 218 & MAP #4342 FOUND BEARING TREES AND OLD STAKE. ERROR IN NOTES. SET W.O. STAKE 2 INCHES NORTH OF OLD STAKE WITH 4 LIMESTONES (ON NORTH, SOUTH, WEST, AND EAST SIDES) IN MOUND. PIT 3 FT. S©SW. SHOWS A DISTANCE OF 2674.32 TO CENTER OF SECTION 12.

1867 LEE VOL 1 PG 331 FOUND STAKE SET BY LOCKE. SHOWS A DISTANCE OF 2644.46 TO CENTER OF SECTION 12.

1868 LOCKE PLYMOUTH TOWNSHIP REMONUMENTATION FIELD NOTES.
PG 31 NORTH ON EAST LINE SEC 12 VAR 6-48

D SET OFF 6.27' WEST

1153.02 CENTER M&M R/R

1320 SET OFF 3.3' EAST

1650 SET OFF 6.27' WEST

1980 SET OFF 6.6' WEST 2310 SET OFF 4.95' WEST

2653.2 INTERSECTE 1/4 LINE 1.32' WEST OF COR. FOUND N.
BT STUMP OF SOUTH BT AND STAKE NORTH BT IS
N79W VAR CORRECTED 7-13

CONTINUED NORTH FROM 1/4 COR WITH VAR 6-48

4488 SET OFF 31.68' WEST

5306.4 INTERSECTED NORTH BOUNDARY 26.4' WEST OF COR.
FOUND NORTH BT COR 5.94' EAST OF CENTER OF
BRIDGE VAR CORRECTED 6-55 AUG 26 1868

1876 RUGER VOL 2 PG 205 CALLS FOR A STONE MONUMENT AT CORNER. SHOWS A DISTANCE OF 2599.08 TO CENTER OF SECTION 12 AND 2645.94 TO NE CORNER OF SECTION 12.

1972 LEE VOL 4 PG 587 DUG AND FOUND NOTHING. SET CAST IRON MONUMENT BY PRORATION.

1972 LEE VOL 4 PG 588 SHOWS THE FOLLOWING DISTANCES IN SECTION 7 OF ROCK TOWNSHIP:

TO SW COR SEC 7 ROCK
W 1/16TH OF NW SEC 7

NO-55-35W 2663.48 NO-55-35W 1331.74 689-29-16E 5343.83

E 1/4 COR SEC 7 589-29-16E 5343 1972 LEE VOL 4 PG 570 SHOWS WPL COORDINATES OF N/S 238,169.78; N/S 2,234,006.65

1974 LEE VOL 5 PG 53 FOUND OUT STONE MONUMENT AT CORNER SHOWS A DISTANCE TO THE SW CORNER OF SECTION 6 OF ROCK TOWNSHIP AS 2648.62'.

1980 BARNES VOL 6 PG 29 SHOWS THE FOLLOWING DISTANCES AND BEARINGS IN SECTION 12:

TO CENTER N89-44-41W 2606.39 SW CORNER N1-05-42W 2651.73

SHEET 1 OF 2 CORNER CODE G-25

Lonal & armes