U.S.


LAND **PUBLIC** SURVEY MONUMENT RECORD

For Public Land Survey Corners in:

WI ADMINISTRATIVE CODE A-E 7.08 REQUIREMENT

√T. 2N., R. //_E

CORNER CODE INDEX

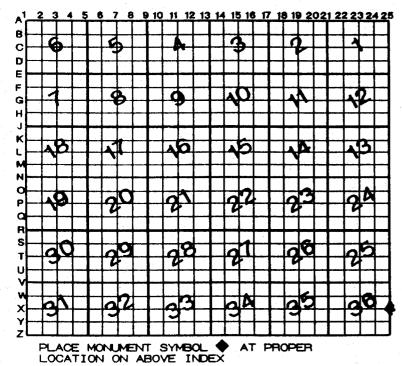

PLYMO UTH ROCK COUNTY WI

IF AVAILABLE ROCK COUNTY COORDINATES PERFERRED

North Elev.

East Hor. Datum _____ Vert. Datum

_ ELLIPS. HT. LATITUDE

LONGITUTE

GPS (X) TRAVERSE (X)

BASED ON THE FOLLOWING CONTROL:

CORNER MONUMENT

O WITNESS MONUMENT

BEARINGS ARE BASED ON

(a)

0	BSERV	TATION	SHEETS
620,	1621,	3515,8	SHEETS 3540

∠ of SHEET . _PAGE # FIELD BOOK_ SHOW A PLAN VIEW DRAWING DEPICTING THE CORNER MONUMENT AND SURROUNDING

PHYSICAL FEATURES, INCLUDING THE EXCAVATION AREA AND DEPTH. PLANNING & ZONING COMMITTEE ADOPTED THE ABOVE FORM ON 12/2/1982

CORNER CODE

PL620

(B) Describe any record evidence, monument evidence, occupational evidence, testimonial evidence or any other material evidence you considered, and whether the monument was found or placed.

1833 MULLETT NORTH ON EAST SIDE SECTION 36

VAR 8-00 E (T2N R11E)

1758.9 WHITE DAK 16 IN DIAMETER

2640 SET QUARTER SECTION POST WHITE OAK 12 N22W

16.5'; WHITE DAK 16 512W 15.18'

SET POST CORNERS SECTIONS 25 & 36 WHITE OAK 5280

> 12 N59W 227.7'; WHITE DAK 18 570W 239.58' LAND ROLLING SECOND RATE TIMBERED WITH WHITE BLACK AND BUR DAK.

1852 Mc VEAN VOL 1 PG 14 VAR 9-11 5278.02' TO W 1/4 COR SEC 36 1854 TOWN ROAD RECORDS BK 1 PG 35 BEGINNING AT THE NE COR OF SEC 25 IN THE TOWN OF PLYMOUTH RUNNING THENCE SOUTH ON THIS TOWN LINE BETWEEN SAID TOWNS TO THE SOUTH LINE OF THE TOWNS AFORESAID; AND THAT THE ""

1868 LOCKE PLYMOUTH REMONUMENTATION

PG 7 SOUTH ON EAST LINE SEC 36 VAR 7-25

2661.12 INTERSECTED 1/4 LINE 3.3' EAST OF COR. FOUND STUMPS OF B.T.S AND OLD STAKE. VAR CORRECTED 7-21

CONTINUED SOUTH FROM 1/4 COR WITH VAR 7-25

5311.68!NTERSECTED SOUTH BOUNDARY 5.61' WEST OF COR FOUND STUMPS OF BTS AND OLD STAKE VAR CORRECTED 7-32 AUG 19, 1868

1870 RUGER VOL 2 PG 46 STONE MON BY LOCKE. VAR 6-52 2641.98 TO SE COR SEC 36

1874 RUGER VOL 2 PG 127 STONE BY LOCKE VAR 5-07 ALONG E/W CENTER LINE SEC 36.

1959 BATTERMAN VOL 4 PB 12 FD CUT STONE & REF. SAME. 216,946.68; 2,234,486.26 WPL

1966 BATTERMAN VOL 4 PG 286 IRON PIPE

1975 SCHROEDER CSM VOL 4 PG 287 STATES NOTHING ABOUT MON.

1978 SCHROEDER CSM VOL 7 PG 178 STATES NOTHING ABOUT MON.

1981 BARNES VOL 6 PG 144 2678.41 TO CEN SEC 31 ROCK TWP., S1-26-02E 2647.01 TO SE COR SEC 36, & N1-37-56W 2658.55 TO NE COR SEC 36.

1990 BARNES X-1 ROCK TWP REPLACED 1"X2' PIPE THAT HAD A 1/2" ROD IN THE INSIDE WITH A POLY. MON. REFERENCED SAME. MON. IS 3' SOUTH CENTER PVMT & 4' WEST OF CENTER OF PVMT.

1992 SCHROEDER CSM VOL 15 PB 382 STATES NOTHING ABOUT MON. 1996 SCHROEDER CSM VOL 19 PG 458 STATES NOTHING ABOUT MON. 1998 COMBS MAP #08111 FD ALUM.

USED MY ROCK TWP PROJECT DBSERVATION SHEETS.

C) Was the corner restored through acceptance of (1) an obliterated evidence location, or, (2) a found perpetuated location?

ACCEPTED POLY MON., WHICH PERPETUATED THE FD CUT L.S.

I, Donald Barnes, hereby certify that the corner location as identified by the corner code index was determined by me under my direction and control and that this U.S. Public Land Survey Monument Record is correct and complete to the best of my knowledge and belief.

Vald Barres 2/15/03

SHEET 1 OF 1

GORNER GODE X-25