## U.S.


## PUBLIC LAND SURVEY MONUMENT RECORD

For Public Land Survey Corners in:

WI ADMINISTRATIVE CODE A-E 7.08 REQUIREMENT

. T. 2 N., R. \_//E

CORNER CODE INDEX

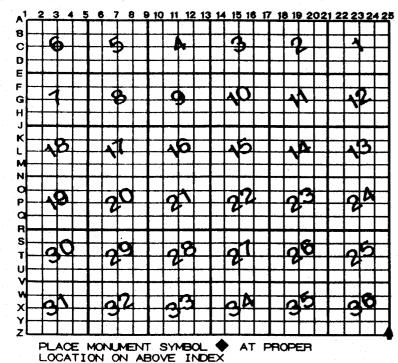

PLYMOUTH TWP ROCK COUNTY WI

IF AVAILABLE
ROCK COUNTY COORDINATES PERFERRED

North \_\_\_\_\_ Elev. \_\_\_\_

Hor. Datum \_\_\_\_\_ Vert. Datum \_\_\_\_

LATITUDE \_\_\_\_\_ELLIPS. HT.

GPS (X) \_\_\_ TRAVERSE (X) \_\_\_

BASED ON THE FOLLOWING CONTROL:

**♦**CORNER MONUMENT

O WITNESS MONUMENT

East

Fd 1998 TIES IN A-1 BELOIT TWP

BEAFINGS ARE BASED ON

(a)

OBSERVATION SHEETS 491, 620, \$633

FIELD BOOK \_\_\_\_\_PAGE # \_\_\_\_\_ SHEET \_/\_ OF \_\_\_\_

SHOW A PLAN VIEW DRAWING DEPICTING THE CORNER MONUMENT AND SURROUNDING PHYSICAL FEATURES, INCLUDING THE EXCAVATION AREA AND DEPTH.

PLANNING & ZONING COMMITTEE ADOPTED THE ABOVE FORM ON 12/2/1962

## PL633

(B)Describe any record evidence, monument evidence, occupational evidence, testimonial evidence or any other material evidence you considered, and whether the monument was found or placed.

1833 MULLETT SEPT ORIGINAL GOVERNMENT SURVEYOR. FIELD NOTES

NORTH ON EAST SIDE SECTION 1

2442 LEAVE PRAIRIE AND ENTER MARSH

2640 SET QUARTER SECTION POST BUR OAK 10 S38W 234.3',

NO OTHER

3399 STREAM 5.28' C E

3564 LEAVE MARSH

5280 SET POST CORNERS TOWNSHIP 1 & 2 N RANGES 11 & 12 E BLACK DAK 8 N53E 19.8', BLACK DAK 6 S32E 9.24' FIRST 1/2 ROLLING RICH PRAIRIE LAST 1/2 LEVEL PART MARSH.

NORTH ON EAST SIDE SECTION 36 VAR 8-00 E (T2NR10E)

1758.9 WHITE DAK 16 IN DIAMETER

2640 SET QUARTER SECTION POST WHITE OAK 12 N22W 16.5';

WHITE OAK 16 S12W 15.18'

5280 SET POST CORNERS SECTIONS 25 & 36 WHITE OAK 12 N59W 227.7'; WHITE OAK 18 S70W 239.58' LAND ROLLING SECOND RATE TIMBERED WITH WHITE BLACK AND BUR OAK.

WEST ON SOUTH SIDE SECTION 36 VAR 7-00 (T2NR10E)

2640 SET QUARTER SECTION POST WHITE DAK 10 N54E

20.46'; WHITE OAK 14 N15W 69.3;

4059 ENTER MARSH

5016 LEAVE MARSH

SET POST CORNER SECTIONS 34 & 36 BLACK OAK 14
N9E 12.54'; WHITE OAK B N64 1/2W 67.9B'. LAND
EXCEPT MARSH ROLLING SECOND RATE THINLY
TIMBERED WITH WHITE BLACK AND BUR OAK
EAST ON SOUTH SIDE SECTION 31 (T2N R12E) VAR 7-25

SET QUARTER SECTION POST BUR DAK 12 N71E 221.76';

HICKORY 10 N84W 278.52'

3003 ENTER MARSH

2640

3811.5 STREAM 9.9' C N.E.

5280 SET POST CORNER SECTIONS 31 & 32 AND MADE MOUND. FIRST 1/2 ROLLING SECOND RATE TIMBER BLACK WHITE AND BUR OAK LAST 1/2 MARSH.

1833 ORIG PLAT CALLS FOR 2640 TO THE E 1/4 COR SEC 17WPIF
1854 TOWN ROAD RECORDS BK 1 PG 35 BEGINNING AT THE NE COR
OF SEC 25 IN THE TOWN OF PLYMOUTH RUNNING THENCE SOUTH ON
THIS TOWN LINE BETWEEN SAID TOWNS TO THE SOUTH LINE OF THE
TOWNS AFORESAID; AND THAT THE ""

1868 LOCKE PLYMOUTH REMONUMENTATION

WEST ON SOUTH BOUNDARY OF SEC 36. VAR 6-30

- 2645.45 INTERSECTED 1/4 LINE 22.44' SOUTH OF COR. FOUND EAST BT AND STUMPS OF WEST BT AND OLD STAKE. COR IN LINE WITH NORTH AND SOUTH FENCES AND 3 FT NORTH OF FENCE RUNNING EAST ON SOUTH SIDE OF HIGHWAY MONUMENT MARKED WITH FIGURES 36. VAR CORRECTED 6 CONTINUED WEST FROM 1/4 COR WITH VAR 5-10
- 5295.34 INTERSECTED WEST BOUNDARY 5.28' NORTH OF COR. FOUND BT IN SEC 35 AND WHERE BT IN 36 WAS DUG OUT.
- 5218.12 INTERSECTED WEST BOUNDARY OF SEC 1 TOWN 1N FOUND BT IN SEC 2 AND OLD STAKE. COR FOR SEC 36 IN CENTER OF N AND S HIGHWAY AND ON SOUTH LINE OF E AND W HIGHWAY VAR CORRECTED 5-17 AUG 19,1868

PG 7 SOUTH ON EAST LINE SEC 36 VAR 7-25

2661.12 INTERSECTED 1/4 LINE 3.3' EAST OF COR. FOUND STUMPS \* OF B.T.S AND OLD STAKE. VAR CORRECTED 7-21 CONTINUED SOUTH FROM 1/4 COR WITH VAR 7-25

Porald Baines 6-17-03

SHEET 1 OF 2 CORNER CODE Z-25

5311.68 INTERSECTED SOUTH BOUNDARY 5.61' WEST OF COR FOUND STUMPS OF BTS AND OLD STAKE VAR CORRECTED 7-32 AUG 19, 1868

1870 RUGER VOL 2 PG 45. FOUND STONE MONUMENT SET BY LOCKE. SHOWS 2446.84 TO THE N 1/4 CORNER OF SECTION 6 BELOIT.

1871 COLLINS REMONUMENTATION NEWARK TWP TIN R11E

EAST ON NORTH LINE SEC 1 ON OFFSET 12.54' NORTH VARIATION 5-15

2584.56 OFFSET 33' SOUTH AND CONTINUED EAST WITH VARIATION 6

5216.64 INTERSECT RANGE LINE 19.8' SOUTH OF CORNER WEST CORRECTED BACK VARIATION 5-17

2608.32 SET 1/4 36.3' EAST OF PLYMOUTH 1/4 CORNER CONTINUED WEST VARIATION 5-17

5216.64 SECTION CORNER OCT 18 1871

NORTH ON EAST LINE OF 1 VARIATION 5-45

2655.18 INTERSECT 1/4 LINE 10.56' EAST OF CORNER. SET 1/4
COR STONE BY STUMPS OF WITNESS TREES CORRECTED
VARIATION 5-30

CONTINUED NORTH VARIATION 5-15

5312.34 INTERSECT TOWN LINE 7.26' EAST OF STONE SET FOR SE CORNER SEC 36 T2R11 AGREEING WITH WITNESS TREES CORRECTED VARIATION 5-05 OCT 13, 1871

1874 RUGER VOL 2 PG 127 STONE MONUMENT.

1881 LEE VOL 2 PG 328 FOUND MONUMENT SHOWS 2448.60 TO N 1/4 CORNER OF SECTION 6 BELOIT TOWNSHIP AND 2647.92 TO W 1/4 CORNER OF SECTION 6.

1959 BATTERMAN VOL 4 PG 11 FOUND CUT LIMESTONE. 1" PIPE IN BLACKTOP. WPL COORDINATES N/S 214,300.60 E/W 2,234,552.50. REFERENCED CORNER.

1966 BATTERMAN VOL 4 PG 286 IRON PIPE

1981 BARNES VOL 6 PG 144 SHOWS THE FOLLOWING DISTANCES:

TO W 1/4 COR SEC 3	31WPL N1-26-02W	2647.01
	LOCKE 1868	2650.56
	RUGER 1870	2641.98
S 1/4 COR SEC 31	RUGER 1870	2651.22
N 1/4 COR SEC 6	RUGER 1870	2446.84
	WPL N89-38-22E	2452.66
W 1/4 COR SEC 6	WPL NO-01-26W	2650.74

COLLINS 1871 2657.16

FOUND 3/4" PIPE THAT IS 2' EAST OF THE CENTER OF THE PAVEMENT.

1989 BARNES BELOIT REMONUMENTATION SO-38-20W 2650.86 TO E 1/4 COR SEC 1.

1998 BARNES A-1 BELOIT TWP FD ¾" PIPE 2' EAST OF CENTER OF PVMT. & REFERENCED SAME.

2000 BARNES USED DATA FROM BELOIT REMONUMENTATION PROJECT

C) Was the corner restored through acceptance of (1) an obliterated evidence location, or, (2) a found perpetuated location?

ACCEPTED PERPETUATED LOCATION AS REPORTED IN BELOIT PROJECT.

I, **Donald Barnes**, hereby certify that the corner location as identified by the corner code index was determined by me under my direction and control and that this U.S. Public Land Survey Monument Record is correct and complete to the best of my knowledge and belief.

seal

Penals Barnes 6-17-03 SHEET % OF 2

CORNER CODE Z-25

A-E 7.08 REQUIREMENT