

U.S. PUBLIC LAND SURVEY MONUMENT RECORD


For Public Land Survey Corners in the
T. 1 N., R. 4 E.

CORNER CODE INDEX

	1	2	3	4	5	6	7	8	9	10	11	12	13	14	15	16	17	18	19	20	21	22	23	24	25
A																									
B																									
C	6																								
D		5																							
E			4																						
F				3																					
G					2																				
H																									
I	7																								
J		8																							
K			9																						
L				10																					
M					11																				
N						12																			
O							13																		
P								14																	
Q									15																
R										16															
S											17														
T												18													
U													19												
V														20											
W															21										
X																22									
Y																	23								
Z																		24							
																			25						
																				26					
																					27				
																						28			
																							29		
																								30	
																									31
																									32
																									33
																									34
																									35
																									36

PLACE MONUMENT SYMBOL (◆) AT PROPER LOCATION ON ABOVE INDEX

EXAMPLE

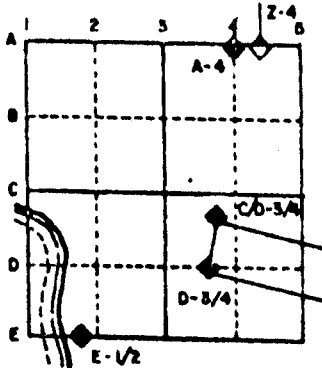

CLINTON TWP
ROCK COUNTY WI

IF AVAILABLE STATE PLANE COORDINATES

North (Y) _____ Eleve. (Z) _____
 East (X) _____ Zone _____
 Hor. Datum _____ Vert. Datum _____

◆ CORNER MONUMENT ○ WITNESS MONUMENT

BEARINGS ARE BASED ON: 1981 CLINTON
TWP PROJ.

NE
COR SEC
13

○
N0-36-16 N 2653.75
LEE 1971 2651.05

E 1/4 COR
SEC 13

○
N1-04-57 W 2648.18
LEE 1971 2651.05

SE COR
SEC 13

MICROFILMED

SHEET ___ OF ___

CORNER CODE: L 25

(B) Describe any record evidence, monument evidence, occupational evidence, testimonial evidence or any other material evidence you considered, and whether the monument was found or placed.

1835 SET QUARTER SECTION POST BUR OAK 12 S43W 112.86', BUR OAK 12 N38W 111.54

1867 LEE VOL 1 PG 332 FOUND OLD STAKE AND SW BT. SHOWS 2630.76 TO THE CENTER OF SECTION 13.

1971 LEE VOL 4 PG 550 SET R/R SPIKE AND REFERENCED SAME. SHOWS THAT THE CORNER IS ON LINE WITH THE NE AND NW CORNERS OF SECTION 13 AND 2651.05 FROM BOTH.

1971 LEE VOL 4 PG 549 SHOWS 2651.05 TO THE NE AND SE CORNERS OF SECTION 13.

1980 BARNES VOL 6 PG 85 SHOWS A R/R SPIKE AND CORNER IS ON LINE WITH THE SE AND NE CORNERS OF SECTION 13 AT MID POINT.

1980 BARNES VOL 6 PG 94 FOUND R/R SPIKE AS PLACED BY LEE. SHOWS DISTANCES TO FENCES AND PAVEMENT.

1981 BARNES TOWNSHIP PROJECT SHOWS

1990 LLOYD JENSEN (WALWORTH COUNTY SURVEYOR)-LETTER. WE DUG AT THE RAILROAD SPIKE THAT WAS IN PLACE. AT ABOUT SIX (6) FEET DOWN, WE FOUND THE EAST SIDE OF AN OLD CORDUROY ROAD AND NO STAKE BELOW THE RAILROAD SPIKE. WE THEN DUG THE REMAINDER OF THE ROAD OUT AND FOUND A SMALL OLD STAKE ABOUT THREE (3) FEET BELOW THE ROAD SURFACE. ABOUT SIX (6) FEET BELOW THE ROAD SURFACE, WE FOUND THE OLD CORDUROY ROADBED AND IN THE CENTER OF THAT, WE FOUND AN OLD STAKE IN GOOD CONDITION. THE GROUND WAS VERY WET SO THE STAKE AND CORDUROY ROAD LOGS WERE IN FAIR CONDITION. THE SMALL STAKE THAT WE FOUND AT A POINT THREE (3) FEET BELOW THE ROAD SURFACE CHECKED WITH THE LARGE STAKE IN THE CENTER OF THE CORDUROY ROAD. WE USED THIS FOR THE LOCATION OF OUR MONUMENT.

FOUND JENSEN'S DISK IN A CONCRETE MONUMENT AND R/R SPIKE.

C) Was the corner restored through acceptance of (1) an obliterated evidence location, or, (2) a found perpetuated location?



ACCEPTED JENSEN'S CONCRETE MONUMENT.

D) Describe any material discrepancy between the location of the corner as restored or reestablished and the location of that corner as previously restored or reestablished by distance and direction. Show the discrepancy on the plan view drawing under (a), above. Show the distances between the corner as previously restored or reestablished and (1) the corner as restored or reestablished, and (2) to at least 4 of the witness monuments shown on the drawing in (a), above.

DISCREPANCY IS SHOWN ON MAP.

(E) Was the corner reestablished through lost corner proportionate methods? If so, show the method, including the directions and distances to other public land survey corners used as evidence or used for proportioning the corner location.

I, Donald Barnes, hereby certify that the corner points as identified by the corner code index were, in a field survey on, October 19, 1990, established, re-established, monumented, re-monumented, recovered or restored as expressed below and in conformance with the regulations and rules as required in the current manual of survey instructions of the United States Department of Interior, Bureau of Land Management.

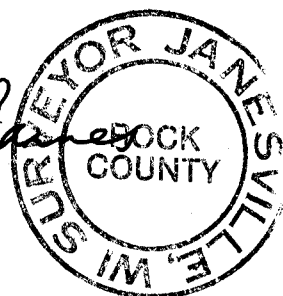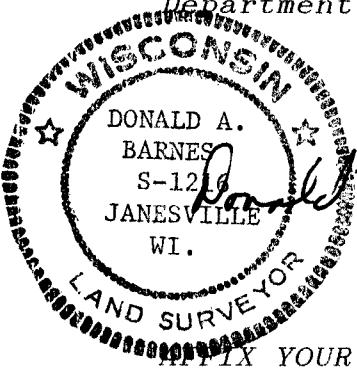

COUNTY SURVEYOR FILING DATA

Date of computer entry _____

Date microfilmed _____

Number of included sheets _____

CORNER CODE

APPLY YOUR LAND SURVEYOR SEAL

125