

PUBLIC LAND SURVEY MONUMENT RECORD

For Public Land Survey Corners in the


T. ___ N., R. ___ E.

CORNER CODE INDEX

	1	2	3	4	5	6	7	8	9	10	11	12	13	14	15	16	17	18	19	20	21	22	23	24	25
A																									
B																									
C	6																								
D		5																							
E			4																						
F				3																					
G					2																				
H	7																								
I		8																							
J			9																						
K				10																					
L					11																				
M						12																			
N	16																								
O		17																							
P			18																						
Q				19																					
R					20																				
S						21																			
T							22																		
U								23																	
V									24																
W										25															
X	30																								
Y		29																							
Z			28																						
				27																					
					26																				
						25																			
PLACE MONUMENT SYMBOL (◆) AT PROPER LOCATION ON ABOVE INDEX

EXAMPLE

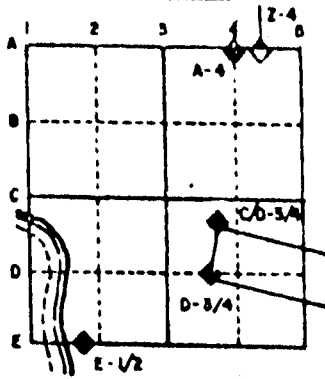

Clinton TWP
ROCK COUNTY WI

IF AVAILABLE
STATE PLANE COORDINATES

North (Y) _____ Eleve. (Z) _____
 East (X) _____ Zone _____
 Hor. Datum _____ Vert. Datum _____

◆ CORNER MONUMENT

○ WITNESS MONUMENT

BEARINGS ARE BASED ON:

RECORD OF U. S. PUBLIC LAND SURVEY CONTROL STATION

U. S. PUBLIC LAND SURVEY CORNER 3631 T 1 N, R 15 E, WALWORTH COUNTY, WIS.
 GEODETIC SURVEY BY: AYRES ASSOCIATES YEAR: 1992


STATE PLANE COORDINATES OF: QUARTER SECTION CORNER
 NORTH 184,339.99
 EAST 2,329,996.82
 ELEVATION OF STATION: 984.442

HORIZONTAL DATUM: WISCONSIN STATE PLANE COORDINATE SYSTEM, SOUTH ZONE
 VERTICAL DATUM: NATIONAL GEODETIC VERTICAL DATUM OF 1929

CONTROL ACCURACY:
 HORIZONTAL: THIRD ORDER, CLASS I VERTICAL: SECOND ORDER, CLASS II THETA ANGLE: + 0-50-26

LOCATION SKETCH:

NOTE: 60 penny nails used for ties.

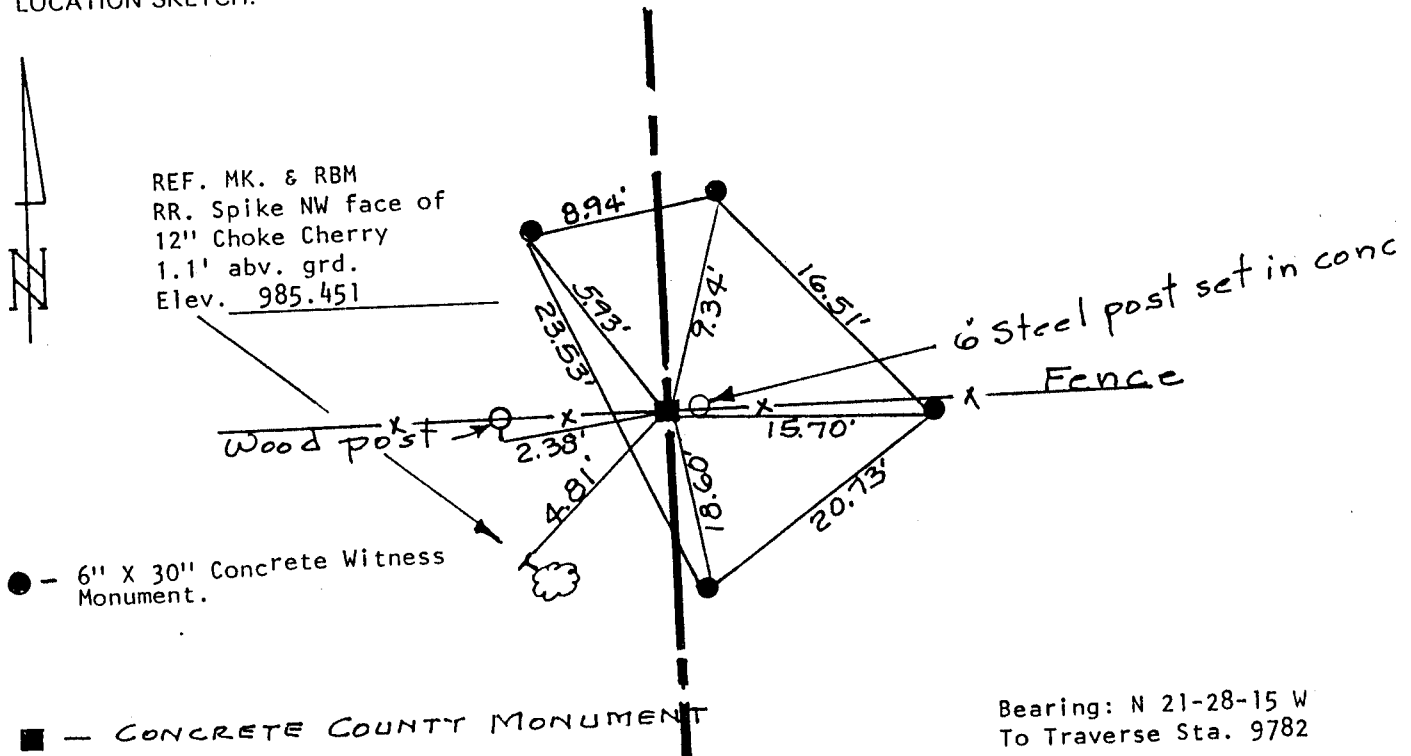

SURVEYOR'S AFFIDAVIT:

STATE OF WISCONSIN)
WALWORTH COUNTY) SS

I hereby certify that I searched the area and excavated the area around the fence corner and I found what I considered good evidence of an old stake adjacent to the 6" steel post that is set in concrete. The fence line to the North shows evidence of having been in place for a very long time judging by the ground build up at the fence line, placed a 6" X 9" X 36" Concrete County Monument at the 1/4 Section corner.

DATE OF SURVEY: 4-28-92

Lloyd L. Jensen
 REGISTERED LAND SURVEYOR

S- 211

FORM PREPARED BY SOUTHEASTERN WISCONSIN REGIONAL PLANNING COMMISSION

A-51