


U.S. PUBLIC LAND SURVEY MONUMENT RECORD

For Public Land Survey Corners in the
T. 1 N., R. 14 E.

CORNER CODE INDEX

	1	2	3	4	5	6	7	8	9	10	11	12	13	14	15	16	17	18	19	20	21	22	23	24	25
A																									
B																									
C																									
D																									
E																									
F																									
G																									
H																									
I																									
J																									
K																									
L																									
M																									
N																									
O																									
P																									
Q																									
R																									
S																									
T																									
U																									
V																									
W																									
X																									
Y																									
Z																									

EXAMPLE

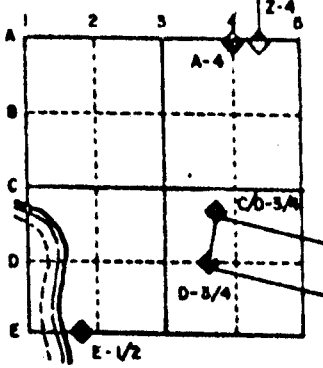

CLINTON TWP
ROCK COUNTY WI

IF AVAILABLE
STATE PLANE COORDINATES

North (Y) _____ Eleve. (Z) _____
 East (X) _____ Zone _____
 Hor. Datum _____ Vert. Datum _____


PLACE MONUMENT SYMBOL (◆) AT PROPER
LOCATION ON ABOVE INDEX

◆ CORNER MONUMENT ○ WITNESS MONUMENT

FIELD BOOK 2 PG 31

- ◆ DISK INSIDE 2" PIPE
- ALUMINUM MONUMENT

3/4"x24" REROD
WITH ORANGE CAP

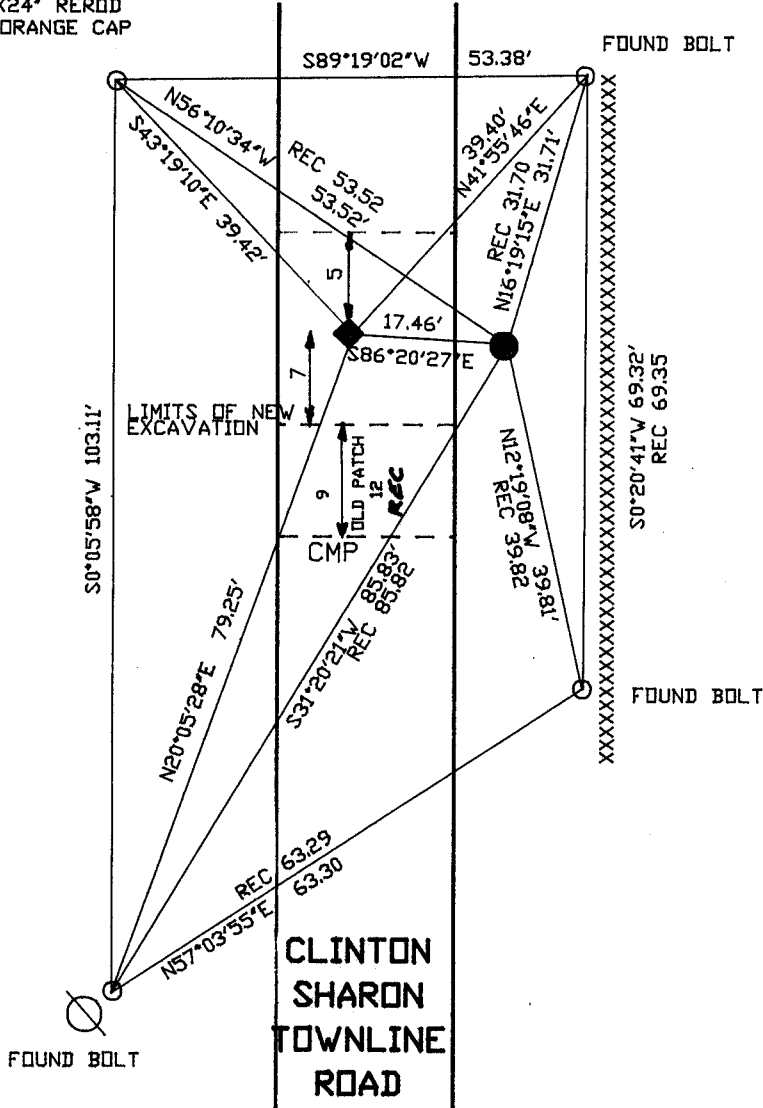

BEARINGS ARE BASED ON: ASSUMED - TIE SHEET
1981 CLINTON PROJ - SECTION DISTANCES & BEARINGS

NE COR
SEC 1

N0-17-28E 3051.06
N0-24-46W 2654.95

E 1/4 COR
SEC 1

SE
COR SEC 1

LEE 1970 6697.06

MICROFILMED

SHEET ___ OF ___

CORNER CODE: C 25

(B) Describe any record evidence, monument evidence, occupational evidence, testimonial evidence or any other material evidence you considered, and whether the monument was found or placed.

1835 ORIGINAL GOV. SURVEY. SET QUARTER SECTION POST. BUR OAK 7 S5 1/2W 213.84, BLACK OAK 10 N69 1/2W 529.32.

1970 BATTERMAN JR. VOL 4 PG 474 DUG AND FOUND NOTHING.

1980 BARNES VOL 6 PG 84 NOTED THAT FORMER COUNTY SURVEYOR DUG AND FOUND NOTHING. MAP SHOWS OLD EXCAVATION. DUG AND FOUND NOTHING. PLACED ALUMINUM MONUMENT ON LINE WITH NE & SE CORNERS OF SECTION 1 AT SINGLE PROPORTIONATE DISTANCE. REFERENCED CORNER.

1990 LLOYD JENSEN (WALWORTH COUNTY SURVEYOR)-LETTER. I HAVE AN OLD RECORD OF A STAKE HAVING BEEN PLACED THERE. WE DUG THERE AND ABOUT EIGHT (8) INCHES WEST OF YOUR EXCAVATION, WE FOUND AN OLD STAKE ABOUT FIVE (5) FEET BELOW THE ROAD SURFACE. WE PLACED A CONCRETE MONUMENT AT THE POINT. IT IS 17.50 WEST OF YOUR MONUMENT.

FOUND ALUMINUM MONUMENT AND DISK IN CONCRETE MONUMENT THAT JENSEN PLACED. CONCRETE MONUMENT WAS WHERE FORMER COUNTY SURVEYOR DUG AND FOUND NOTHING.

C) Was the corner restored through acceptance of (1) an obliterated evidence location, or, (2) a found perpetuated location?


ACCEPTED JENSEN'S FOUND PERPETUATED LOCATION.

D) Describe any material discrepancy between the location of the corner as restored or reestablished and the location of that corner as previously restored or reestablished by distance and direction. Show the discrepancy on the plan view drawing under (a), above. Show the distances between the corner as previously restored or reestablished and (1) the corner as restored or reestablished, and (2) to at least 4 of the witness monuments shown on the drawing in (a), above.

DISCREPANCY IS SHOWN IN DRAWING.

(E) Was the corner reestablished through lost corner proportionate methods? If so, show the method, including the directions and distances to other public land survey corners used as evidence or used for proportioning the corner location.

I, Donald Barnes, hereby certify that the corner points as identified by the corner code index were, in a field survey on, October 19, 1990, established, re-established, monumented, re-monumented, recovered or restored as expressed below and in conformance with the regulations and rules as required in the current manual of survey instructions of the United States Department of Interior, Bureau of Land Management.

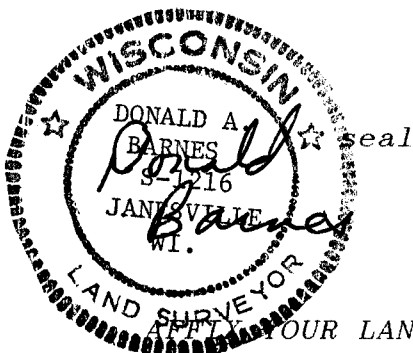

COUNTY SURVEYOR FILING DATA

Date of computer entry _____

Date microfilmed _____

Number of included sheets _____
CORNER CODE

YOUR LAND SURVEYOR SEAL