U.S.


PUBLIC LAND SURVEY MONUMENT RECORD

For Public Land Survey Corners in:

WI ADMINISTRATIVE CODE A-E 7.08 REQUIREMENT

, T.∠N, R. //_E

CORNER CODE INDEX

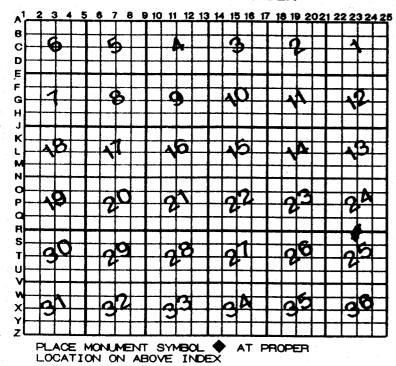

PLYMOUTH TWP ROCK COUNTY WI

IF AVAILABLE
ROCK COUNTY COORDINATES PERFERRED

North _____ Elev. ____

East _____ Vert. Datum ____

LATITUDE ____ ELLIPS. HT.

LONGITUTE ____ TRAVERSE (X) ___

BASED ON THE FOLLOWING CONTROL:

♦ CORNER MONUMENT

O WITNESS MONUMENT

BEAFINGS ARE BASED ON

(a)

OBSERVATION SHEETS 60,201,592		
FIELD BOOKPAGE #	SHEET OF	2_
SHOW A PLAN VIEW DRAWING DEPICTING THE CORNER MONUMENT PHYSICAL FEATURES, INCLUDING THE EXCAVATION AREA AND DEPTH	AND SURROUNDING	
PLANNING & ZONING COMMITTEE ADOPTED THE ABOVE FORM ON 12/2/1982		
	0 - 5	

PL592

(B) Describe any record evidence, monument evidence, occupational evidence, testimonial evidence or any other material evidence you considered, and whether the monument was found or placed.

1833 HARRISON

EAST BETWEEN SEC 24 & 25

2640 TEMP 1/4 P

3630 LEFT TIMBER & ENTER MARSH

5294.52 INT. E BDY 76.56' N OF P LAND HIGH RICH & ROLLING FOR THE 1ST 1/4 MILE WITH TIMBER HICHY, W.O. BURR O RED O & LAST 1/2 LEVEL & WET 3RD RATE BEING MARSH

WEST COR. WEST

2442 HICKY 12

2647.26 QUARTER SEC COR {W.O. 24 S73W 14.52' W.O. 36 S15E 40.92' W.O. 24 W.O. 36} MARKED

5148 BUR 0 24

5294.52 SEC COR.

1853 TWP RD REC BK 1 PG 30 & 31""" HWY BE LAID OUT IN SAID TOWN OF THE WIDTH OF 66' WIDE AND HAVE CAUSED A SURVEY THERE OF TO BE MADE AS FOLLOWS: THE CENTER LINE OF THE SAID HWY IS TO COMMENCE 1320' EAST OF THE SW COR OF SEC 23; THENCE RUNNING EAST ON THE SEC LINE TO THE SW COR OF SEC 24; THENCE EAST 825' RUNNING 33' SOUTH AND PARALLEL WITH SECTION LINE BETWEEN SECS 24 AND 25; THENCE EAST ON THE SECTION LINE BETWEEN 24 AND 25 TO THE EAST LINE OF SAID TOWN.

1868 LOCKE

PG3 EAST BETWEEN SECS 24 & 25

O SET OFF 14.85' SOUTH VAR 6-30E

1320 SET OFF 8.58' SOUTH

2661.45 INTERSECTED 1/4 LINE 2.64' NORTH OF 1/4 COR FOUND STUMPS OF B.T.S & OLD STAKE COR IN CENTER OF HIGHWAY & IN LINE WITH FENCES RUNNING NORTH AND SOUTH VAR CORRECTED 5-56 CONTINUED EAST FROM 1/4 COR WITH VAR 6-10

3498 SET OFF 46.2' SOUTH

5332.47 INTERSECTED EAST BOUNDARY 15.18' NORTH OF COR. FOUND MOUND IN LINE WITH FENCES RUNNING SOUTH & EAST VAR CORRECTED 4-50 AUG 18, 1868

1892 BLEEDORN VOL 2 PG 466 MON. 2663.10 TO SE COR SEC 24 & VAR 4-44 2634.72 TO CENTER SEC 24

1961 BATTERMAN VOL 4 PG 121 DUG 15X12X3 HOLE AT N 1/4 COR SEC 25 & FD CUT STONE MON. REFERENCED SAME

1971 SHARKEY CSM 2-187 CHECK PAPER COPY FOR SYMBOL

1972 SHIMEALL CSM VOL 2 PG 239 STATES NOTHING ABOUT MON.

1978 COMBS CSM VOL 7 PG 246 PK 1338.25 WEST TO $1/16^{TH}$ COR

1981 THOM CSM VOL 10 PG 379 COUNTY SURVEY MON.

1981 BARNES VOL 6 PG 195 SET ALUM. FROM TIES. 3' SOUTH OF NORTH PVMT EDGE

1981 BARNES R-21 S88-43-33E 2666.42 TO NE COR SEC 25 & N89-34-09W 2664.01 TO NW COR SEC 25, & N89-40-43W 2676.17 TO ERRONEOUS MON.

1982 BARNES VOL 6 PG 282 N89-34-09W 2664.01 TO SW COR SEC 24 & N88-43-33E 2666.42 TO SE COR SEC 24.

1992 KREBS MAP #11229 FD ALUM. 2666.50 TO NE COR SEC 25.

1995 KREBS MAP #09256 C.I. 2680.86 TO CEN SEC 25

1996 KREBS MAP #08905 FD ALUM. S88-57-40W 2664.23 TO SW COR SEC 24 S88-07-40E 2666.57 TO SE COR SEC 23, & NO-11-00E 2630.30 TO CEN SEC 24, & NO-11-00E 5281.3 TO N 1/4 COR SEC 24

1998 HOULE CSM VOL 21 PG 339 FD ALUM. 2680.86 TO CEN SEC 25.

2001 COMBS MAP #07940 FD ALUM.

2001 COMBS CSM VOL 24 PG 224 COMPUTED FROM COUNTY SURVEYOR REF. MONUMENTS 2679.03 TO NE COR SEC 25

Donald Baines 3-07-03

SHEET 1 OF 2 CORNER CODE R-23

PL592

2002 ERICKSON FED PRELIMINARY 224,947.352 N/S; 2,200,097.357E/W NAD83 REDUCED TO COUNTY 243,3986.78N/S; 461,845.12E/W S89-49-24W 2664.31 NAD83 TO SW COR SEC 24, S89-20-38E 2666.45 NAD83 TO SE COR SEC 24, NO1-24-04W 2630.20 TO CEN SEC 24, NO1-24-04W 5281.60

FD ALUM. MON.

C) Was the corner restored through acceptance of (1) an obliterated evidence location, or, (2) a found perpetuated location?

USED MY OLD FIELD OBSERVATIONS. ACCEPTED FD ALUM. MON, WHICH PERPETUATES THE CUT L.S. Fd TIES

- D) Describe any material discrepancy between the location of the corner as restored or reestablished and the location of that corner as previously restored or reestablished by distance and direction. Show the discrepancy on the plan view drawing under (a), above. Show the distances between the corner as previously restored or reestablished and (1) the corner as restored or reestablished, and (2) to at least 4 of the witness monuments shown on the drawing in (a), above.
- (E) Was the corner reestablished through lost corner proportionate methods? If so, show the method, including the directions and distances to other public land survey corners used as evidence or used for proportioning the corner location.

I, **Donald Barnes**, hereby certify that the corner location as identified by the corner code index was determined by me under my direction and control and that this U.S. Public Land Survey Monument Record is correct and complete to the best of my knowledge and belief.

Emboss

JUNE 9, 2003

SHEET 2 OF 2

CORNER CODE R-23

A.E. 7.08 REQUIREMENT