

U.S. PUBLIC LAND SURVEY MONUMENT RECORD

For Public Land Survey Corners in the T. 2 N., R. 1/1 E.

CORNER CODE INDEX

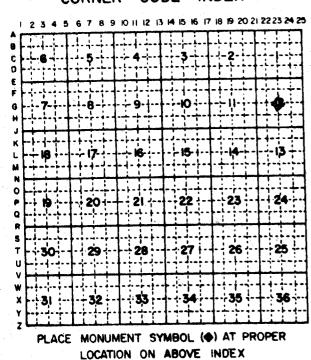

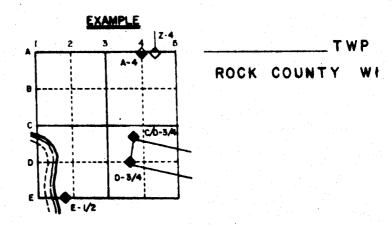


IF AVAILABLE
STATE PLANE COORDINATES

RECORD 238/8/.39 Eleve. (2)

RECORD 223/4-00,29 Zone

Hor. Datum _____ Vert. Datum ____

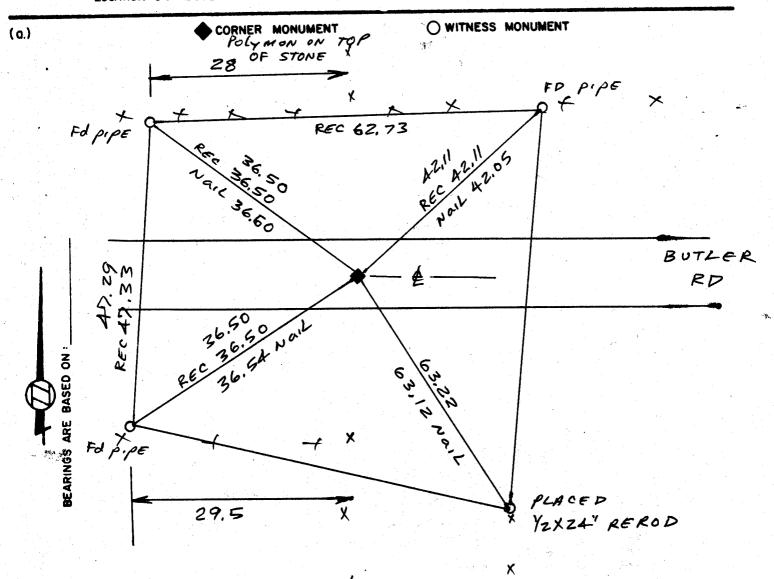

FIELD BOOK 2 PAGE # 53

MICROFILMED

SHOW A PLAN VIEW DRAWING DEPICTING THE CORNER MONUMENT AND SURROUNDING PHYSICAL FEATURES, INCLUDING THE EXCAVATION AREA AND DEPTH. THE CORNER MONUMENT SHALL HAVE THE FOLLOWING CHARACTERISTICS: I) HAVE AT LEAST TWO PREDETERMINED BREAK-OFF POINTS. 2) IF BROKEN, LEAVE A PERMANENTLY MAGNETIZED REMNANT AT THE ORIGINAL POINT. 3) MUST BE EXTENDABLE. 4) THE CAP IS INSCRIBED ROCK COUNTY SURVEY MONUMENT - PENALTY FOR DISTURBING MARKER. 9) OR AN EXISTING CUT LIMESTONE. AN IRON PIPE I'2" & 4'0" (MINIMUM) MAY BE USED IN AREAS WHERE GROUND WATER IS WITHIN ONE FOOT OF THE SURFACE. IF THE CORNER IS OCCUPIED BY AN IMPROVEMENT (MANHOLE, BURIED CABLE, ETC.) ANY DURABLE, DISTINCT MONUMENT MAY BE USED. CORNERS SHALL BE REFERENCED WITH AT LEAST 4 DURABLE WITNESS MONUMENTS. WITNESS MONUMENTS SHALL BE MADE OF CONCRETE, NATURAL STONE, IRON OR OTHER EQUALLY DURABLE MATERIAL, EXCEPT WOOD. DESCRIBE THE CORNER AND THE WITNESS MONUMENTS.

CORNER CODE

623

- (b.) Describe any record evidence, monument evidence, occupational evidence, testimonial evidence or any other material evidence you considered, and whether the monument was found or placed.
 - 1864 LOCKE VOL 1 PG 218 PLACED BR.O. STAKE WITH GREY HARD ON N. RED HARDS ON SOUTH AND RED HARDHEAD ON W AND SMALL HARD ON EAST. SHOWS BEARING TREES. MAP SHOWS THAT THE CORNER WAS PLACED EQUAL DISTANCE FROM ALL QUARTER CORNERS.

1876 RUGER VOL 2 PG 205 PLACED HH 16 X 8 X 7 AT INTERSECTION OF QUARTER LINES.

1966 BATTERMAN JR. VOL 4 PG 295 DUG AND FOUND 16 X 18 x 7 HARDHEAD SET BY RUGER. REFERENCED CORNER. I FOUND 2 PKs .5' DEEP AND A NAIL .8' DEEP. USED TIES TO LOCATE CORNER.

(c.) Was the corner restored through acceptance of (1) an obliterated evidence location, or, (2) a found perpetuated location?


CORNER IS PERPETUATED AS RECORDED.

(d.) Describe any material discrepancy between the location of the corner as restored or reestablished and the location of that corner as previously restored or reestablished by distance and direction. Show the discrepancy on the plan view drawing under (o), above. Show the distances between the corner as previously restored or reestablished and (1) the corner as restored or reestablished, and (2) to at least 4 of the witness monuments shown on the drawing in (e), above.

THERE IS A DISCREPANCY BETWEEN THIS CORNER AND THE ONE THAT LOCKE PLACED.

(e) Was the corner reestablished through lost corner proportionate methods? If so, show the method, including the directions and distances to other public land survey corners used as evidence or used for proportioning in determining the corner location.

I, Done Bournes, hereby certify that the corner points as identified by the corner code index were, in a field survey on June 7 1988, established, re-established, monumented, re-monumented, recovered or restored as expressed below and in conformance with the regulations and rules as required in the current manual of survey instructions of the United States Department of Interior, Bureau of Land Management.

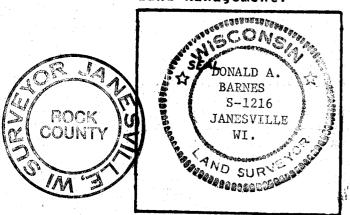

COUNTY SURVEYOR FILING DATA	
Date of Computer Entry	
Date Received	
Date Microfilmed	
Treasurer's Receipt No.	
Number of Included Sheets	
	CORNER

AFFIX YOUR LAND SURVEYOR SEAL. CODE 6-23