

(b.) Describe any record evidence, monument evidence, occupational evidence, testimonial evidence or any other material evidence you considered, and whether the monument was found or placed.

1855 CHURCH VOL 1 PG 53 FOUND STUMPS TO QR. POST
1855 CHURCH VOL 1 PG 54. STATES NOTHING ABOUT CORNER. USED CORNER TO SUBDIVIDE SECTION 8.
1870 RUGER VOL 2 PG 29 FOUND REMAINS OF OLD STAKE & REMAINS OF STUMPS OF BEARING TREES. SET SANDSTONE 17x12x7 & SURROUNDED IT WITH 4 SANDSTONES.
1906 KERCH VOL 3 PG 38 FOUND 1/4 SEC COR AS SET BY RUGER. UNDER SOUTH END OF BRIDGE.
1965 SHIMEALL PLAT OF SURVEY SHOWS PIN AT CORNER. ALSO PLACED REFERENCE TIES.
1980 COMBS CSM VOL 10 PG 138 SHOWS A PK AT THE CORNER.
1986 COMBS PLAT OF SURVEY. DOES NOT STATE WHAT HE FOUND.


(c.) Was the corner restored through acceptance of (1) an obliterated evidence location, or, (2) a found perpetuated location?
FOUND PK THAT WAS IN HARMONY WITH SHIMEALL'S REFERENCE PIPES.

REFERENCED FOUND MONUMENTS. MONUMENTS WILL BE DESTROYED IN ROAD CONSTRUCTION PROJECT.

(d.) Describe any material discrepancy between the location of the corner as restored or reestablished and the location of that corner as previously restored or reestablished by distance and direction. Show the discrepancy on the plan view drawing under (a), above. Show the distances between the corner as previously restored or reestablished and (1) the corner as restored or reestablished, and (2) to at least 4 of the witness monuments shown on the drawing in (a), above.

(e.) Was the corner reestablished through lost corner proportionate methods? If so, show the method, including the directions and distances to other public land survey corners used as evidence or used for proportioning in determining the corner location.

I, Donald Barnes, hereby certify that the corner points as identified by the corner code index were, in a field survey on May 22 1989, established, re-established, monumented, re-monumented, recovered or restored as expressed below and in conformance with the regulations and rules as required in the current manual of survey instructions of the United States Department of Interior, Bureau of Land Management.

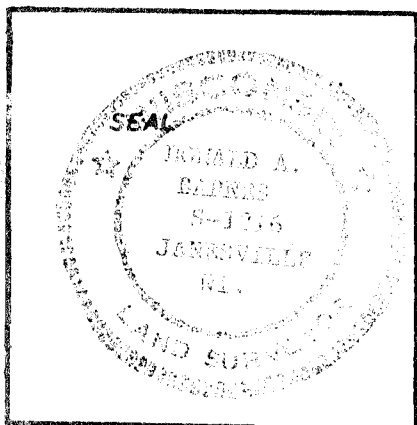

COUNTY SURVEYOR FILING DATA
Date of Computer Entry _____
Date Received _____
Date Microfilmed _____
Treasurer's Receipt No. _____
Number of Included Sheets _____

AFFIX YOUR LAND SURVEYOR SEAL. CORNER CODE 65