

- (b.) Describe any record evidence, monument evidence, occupational evidence, testimonial evidence or any other material evidence you considered, and whether the monument was found or placed.
1. HARRISON 1833 PLACED WOOD POST & MARKED BT BUR OAK 12N53E 90, BUR OAK 14N8W 210 BUR OAK 20S43E310.
 2. CHURCH 1858 MEASURED TO THE CORNER BUT DID NOT STATE WHAT THE MONUMENT WAS. STATED THE FIELD NOTES WERE INCORRECT, BUR OAK WAS 16N7½W 166½links.
 3. RUGER 1882 FOUND NW BT & SE BT & WHERE NE BT HAD BEEN DUG OUT. HE MEASURED TO THE CORNER BUT DID NOT STATE WHAT HE FOUND OR PLACED.
 4. RUGER NO DATE: STATED THAT HE DID NOT PUT IN A PERMANENT CORNER AS PARTIES ADJACENT DID NOT ASSIST IN THIS SURVEY. BUR OAK 10N8W163, BUR OAK 26S43E325, THE SUMP OF THE NE BT HAD BEEN DUG UP, IT WAS N53E134. THE BEARINGS OF ALL AGREED, BUT THE DISTANCES ARE NOT AS GIVEN IN FIELD NOTES
 5. R.H. BATTERMAN JR. 1960 PLACED 1" IRON PIPE AND REFERENCED MONUMENT, BUT DID NOT STATE HOW IS ESTABLISHED THE CORNER.

DUG AND FOUND 3' DEEP OLD PAVEMENT. FOUND R/R SPIKE INSIDE 1" PIPE IN PAVEMENT


- (c.) Was the corner restored through acceptance of (1) an obliterated evidence location, or (2) a found perpetuated location?

ACCEPTED FOUND PERPETUATED LOCATION

- (d.) Describe any material discrepancy between the location of the corner as restored or reestablished and the location of that corner as previously restored or reestablished by distance and direction. Show the discrepancy on the plan view drawing under (a), above. Show the distances between the corner as previously restored or reestablished and (1) the corner as restored or reestablished, and (2) to at least 4 of the witness monuments shown on the drawing in (a), above.

- (e.) Was the corner reestablished through lost corner proportionate methods? If so, show the method, including the directions and distances to other public land survey corners used as evidence or used for proportioning in determining the corner location.

I, Donald A. Barnes, hereby certify that the corner points as identified by the corner code index were, in a field survey on Aug 7 1985, established, re-established, monumented, re-monumented, recovered or restored as expressed below and in conformance with the regulations and rules as required in the current manual of survey instructions of the United States Department of Interior, Bureau of Land Management.

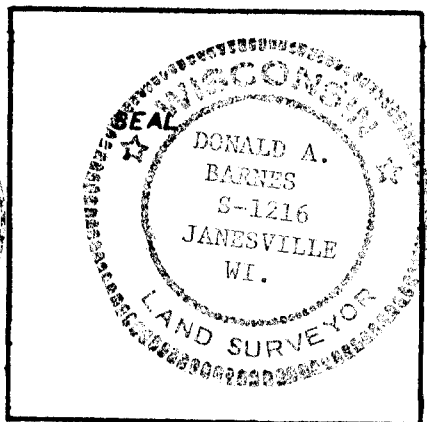

COUNTY SURVEYOR FILING DATA

Date of Computer Entry _____

Date Received _____

Date Microfilmed AUGUST 1985

Treasurer's Receipt No. _____

Number of Included Sheets _____

AFFIX YOUR LAND SURVEYOR SEAL. CORNER CODE V-5