

U.S. PUBLIC LAND SURVEY MONUMENT RECORD

For Public Land Survey Corners in:

WI ADMINISTRATIVE CODE A-E 7.08 REQUIREMENT

T. 3N., R. 10E

CORNER CODE INDEX

A	1	2	3	4	5	6	7	8	9	10	11	12	13	14	15	16	17	18	19	20	21	22	23	24	25
B																									
C	6						5				A			3			2						1		
D																									
E																									
F																									
G	1						8			9			10				11					12			
H																									
I																									
J																									
K																									
L	18						17			16			15			14					13				
M																									
N																									
O																									
P	19						20			21			22			23					24				
Q																									
R																									
S																									
T	30						29			28			27			26					25				
U																									
V																									
W																									
X	31						32			33			34			35					36				
Y																									
Z																									

MAGNOLIA TWP

ROCK COUNTY WI

IF AVAILABLE
ROCK COUNTY COORDINATES REFERRED

North _____ Elev. _____

East _____

Hor. Datum _____ Vert. Datum _____

LATITUDE _____ ELLIPS. HT. _____

LONGITUDE _____

GPS (X) _____ TRAVERSE (X) _____

BASED ON THE FOLLOWING CONTROL:

PLACE MONUMENT SYMBOL AT PROPER LOCATION ON ABOVE INDEX

CORNER MONUMENT

WITNESS MONUMENT

(a)

BEARINGS ARE BASED ON:

FIELD BOOK _____ PAGE # _____

SHEET 1 OF 3

SHOW A PLAN VIEW DRAWING DEPICTING THE CORNER MONUMENT AND SURROUNDING PHYSICAL FEATURES, INCLUDING THE EXCAVATION AREA AND DEPTH.

PLANNING & ZONING COMMITTEE ADOPTED THE ABOVE FORM ON 12/2/1982

CORNER CODE X25

Ma620

(B) Describe any record evidence, monument evidence, occupational evidence, testimonial evidence or any other material evidence you considered, and whether the monument was found or placed.

- 1833 MULLET BY OBSERVATION VARIATION B-15E TAKEN AT THIS CORNER NORTH ON EAST SIDE OF SECTION 36 (MAGNOLIA TWP).
990 CROSS EASTERN PART OF A LEDGE.
1650 ENTER PRAIRIE
2640 SET QUARTER SECTION POST IN PRAIRIE & RAISED A MOUND OF EARTH COVERED WITH SOD
4473.48 TO A STREAM 1.98' WIDE @ EAST
5115 TO A STREAM 3.96' @ S.E.
5280 SET POST FOR CORNER TO SECTIONS 25 & 36 IN PRAIRIE AND MADE MOUND 3 FEET HIGH & 3 FEET DIAMETER AT THE BASE. LAND SOUTH OF PRAIRIE CREEK TIMBER B & W DAK. PRAIRIE LEVEL AND RICH FIRST RATE COVERED WITH GRASS AND A VARIETY OF PLANTS UNKNOWN.
- 1833 HARRISON WEST BET. SECS. 30 & 31
2640 SET QUARTER SEC. COR. IN LOW GROUND. POST & RAISED MOUND.
2676.3 BROOK 3.3' CRSS S.E.
5192.22 INT. WEST BDY 28.38' N. OF P. POST & RAISED MOUND. LAND & C SAME & NOTHING.
- 1867 LOCKE VOL 1 PG 306 SHOWS COR 14.19' NORTH OF E 1/4 COR SEC 36 BUT STATES NOTHING ABOUT COR. USED TO SUBDIVIDE SEC 31. FD POST IN MOUND AT E 1/4 COR SEC 36. (TO ESTABLISH THE DISTANCE BETWEEN THE E 1/4 COR SEC 36 & THE W 1/4 COR SEC 31, HE DIVIDED THE ORIG. GOV. JOG DISTANCE OF 28.38' AT THE NE COR SEC 36)
- 1868 LOCKE REMONUMENTATION FIELD NOTES OF PLYMOUTH TWP.
WEST ON NORTH LINE SEC 6 VAR 6-53
727.98 CREEK 6.6' WIDE CRSS SE
2657.82 INTERSECTED 1/4 LINE AT COR. FD COR AS SET BY SELF (SEE CO. SURVEYORS RECORD) COR. ON SOUTH SIDE OF HIGHWAY IN LINE WITH BOARD FENCES RUNNING N AND E AND 6 INCHES WEST OF COR POST. CONTINUED WEST WITH VAR 6-20
5262.51 INTERSECTED WEST BOUNDARY 43.72' NORTH OF COR. COR. LOST. SET IT IN BY "PROPORTIONAL DISTANCE" FROM 1/4 CORNERS N,S,E, & W. THAT IS 2604.6 FROM E 1/4 COR. 2644.29 FROM W 1/4 COR. 2649.57 FROM N 1/4 COR AND 2649.57 FROM S 1/4 COR. VAR CORRECTED 7-17
- 1870 RUGER VOL 2 PG 36 SHOWS W 1/4 COR SEC 31 NORTH OF E 1/4 COR SEC 36 BUT STATES NOTHING ABOUT IT. FOUND OLD STAKE & SET SANDSTONE 14X12X7 & SURROUNDED IT WITH SMALL SANDSTONES. 2644.95 TO SE COR SEC 36, 2625.87 TO NE COR SEC 36, 2624.66 TO CENTER OF SEC 36, & 5243.20 TO W 1/4 COR SEC 36.
- 1979 BARNES VOL 5 PG 560 DUG 2' DEEP & FOUND SANDSTONE 14X12X7 SURROUNDED BY SMALL SANDSTONES. PLACED I.P. ON NORTH SIDE 3.5' DEEP. SET ALUMINUM MONUMENT ON TOP OF STONE. ON LINE WITH FENCE TO WEST. DUG A HOLE 14' SOUTH OF CORNER AND EXTENDED HOLE 18 NORTH. E/W FENCE LINE GOING EAST IS NORTH OF FD STONE. DUG 3' DEEP AND FOUND NOTHING AT POSSIBLE W 1/4 COR SEC 31. (REVISED RECORD. E 1/4 COR SEC 36 IS NOW THE FD SANDSTONE AND THE W 1/4 COR SEC 31 IS THE FOUND NOTHING.)
- 1984 BARNES VOL 6 PG 317 FD SANDSTONE. SET ALUM MON ON TOP OF STONE @ E 1/4 COR SEC 36. 2647.91 TO SE COR SEC 36 & 2641.87 TO NE COR SEC 36. FD NOTHING AT W 1/4 COR SEC 31. SHOWS 2661.90 TO SW COR SEC 31, 2656.34 TO NW COR SEC 31, 5242.91' TO E 1/4 COR SEC 31 FROM A PT 13.99' NORTH OF THE E 1/4 COR SEC 36.
- 1997 BARNES READJUSTMENT OF 1978 CENTER TWP PROJECT. NW COR SEC 31 TO W 1/4 COR SEC 2656.26, W 1/4 COR SEC 31 TO SW COR SEC 31, E 1/4 COR SEC 36 TO W 1/4 COR SEC 31 13.99, NE COR SEC 36 TO E 1/4 COR SEC 36 2641.80, & E 1/4 COR E 1/4 COR SEC 36 TO SE COR SEC 36 2647.97
- 1998 BARNES Z-23 CALLS FOR 2647.96 TO SE COR SEC 36, 2641.79 TO NE COR SEC 36, 5259.23 TO W 1/4 COR SEC 36; & FROM A PT 13.99 NORTH OF E 1/4 COR SEC 36 2656.25 TO NW COR SEC 31 & 2661.95 TO SW COR SEC 31.
THE RECORD JOG DISTANCES OF 13.99' BETWEEN THE E 1/4

COR SEC 36 & THE W 1/4 COR SEC 31 WAS INCORRECTLY TRANSCRIBED. LOCKE'S DISTANCE IS .21 1/2 CHAINS AND NOT ".212". HIS JOG DISTANCE IS 14.19.

DID NOT PLACE A MONUMENT AT THE W 1/4 COR SEC 31. THIS RECORD IS TO CONSOLIDATE THE ACTIVITIES OF RECORD AND TO CORRECT RECORDS I MADE CONCERNING THE W 1/4 COR OF SEC 31 CENTER TWP AND THE TRANSCRIPTION ERROR OF LOCKE'S RECORD JOG AT THE W 1/4 COR OF SEC 31.

C) Was the corner restored through acceptance of (1) an obliterated evidence location, or, (2) a found perpetuated location?

ACCEPTED THE ALUM. MON. ON TOP OF THE FD SANDSTONE AS THE E 1/4 COR SEC 36 AS PERPETUATED.

D) Describe any material discrepancy between the location of the corner as restored or reestablished and the location of that corner as previously restored or reestablished by distance and direction. Show the discrepancy on the plan view drawing under (a), above. Show the distances between the corner as previously restored or reestablished and (1) the corner as restored or reestablished, and (2) to at least 4 of the witness monuments shown on the drawing in (a), above.

LOGKE DID NOT PLACE THE W 1/4 COR OF SEC 31 MIDWAY BETWEEN THE NW & SW CORNERS OF SEC 31 AS PRESCRIBED BY THE BLM MANUAL. INSTEAD OF HIS JOG OF 14.19' THE DISTANCE SHOULD BE 11.14'. THE DISTANCE BETWEEN THIS LOCATION & THE NW & SW CORNERS OF SEC 31 IS 2659.11. THE W 1/4 COR OF SEC 31 IS ON LINE WITH THE E 1/4 COR SEC 36 AND THE NE COR SEC 36 AT A DISTANCE OF 11.14'.

(E) Was the corner reestablished through lost corner proportionate methods? If so, show the method, including the directions and distances to other public land survey corners used as evidence or used for proportioning the corner location.

THE W 1/4 COR SEC 31 WAS NEVER ESTABLISHED BY THE ORIGINAL GOV. SURVEY. IT SHOULD BE ESTABLISHED MIDWAY BETWEEN THE NW & SW CORNERS OF SEC 31 ON LINE BETWEEN THE E 1/4 COR SEC 36 AND THE NE COR. OF SEC 36 A DISTANCE OF 11.14'.

I, Donald Barnes, hereby certify that the corner location as identified by the corner code index was determined by me under my direction and control and that this U.S. Public Land Survey Monument Record is correct and complete to the best of my knowledge and belief.

Seal

Donald Barnes
01/17/01
Emboss

2 OF 3 SHEETS

CORNER CODE **X-25**

A-E 7.08 REQUIREMENT

NO-21-16W 28.45
 BATTERMAN 28.35
 BARNES 28.45
 RUGER 28.38
 LOCKE 28.28
 DRIG 28.38

Donald Barnes
 EMBOSSED
 SEAL
 01/17/01

30
 SEC 1

LOCKE 14.19
 NO-21-13W 11.14
 FD SANDSTONE E 1/4 COR

NE COR	NW COR	SE COR	SW COR
NO-21-14W 2641.80	BARNES 2656.25	NO-28-07W 2647.97	NO-28-06W 2659.11
NO-21-14W 2641.79	BARNES 2659.11	NO-21-14W 2647.96	NO-28-06W 2659.11
DRIG 2640.	RUGER 2625.8	NO-21-14W 2649.57	BARNES 2661.95
BARNES 2641.79	DRIG 2640.	LOCKE 2644.95	W 1/4 COR
DRIG 2640.	RUGER 2625.8	RUGER 2640	
		DRIG 2640	

30
 SEC 6

MAGNOLIA TWP


CENTER TWP

SPRING VALLEY TWP

PLYMOUTH TWP

SEC 1

SEC 6

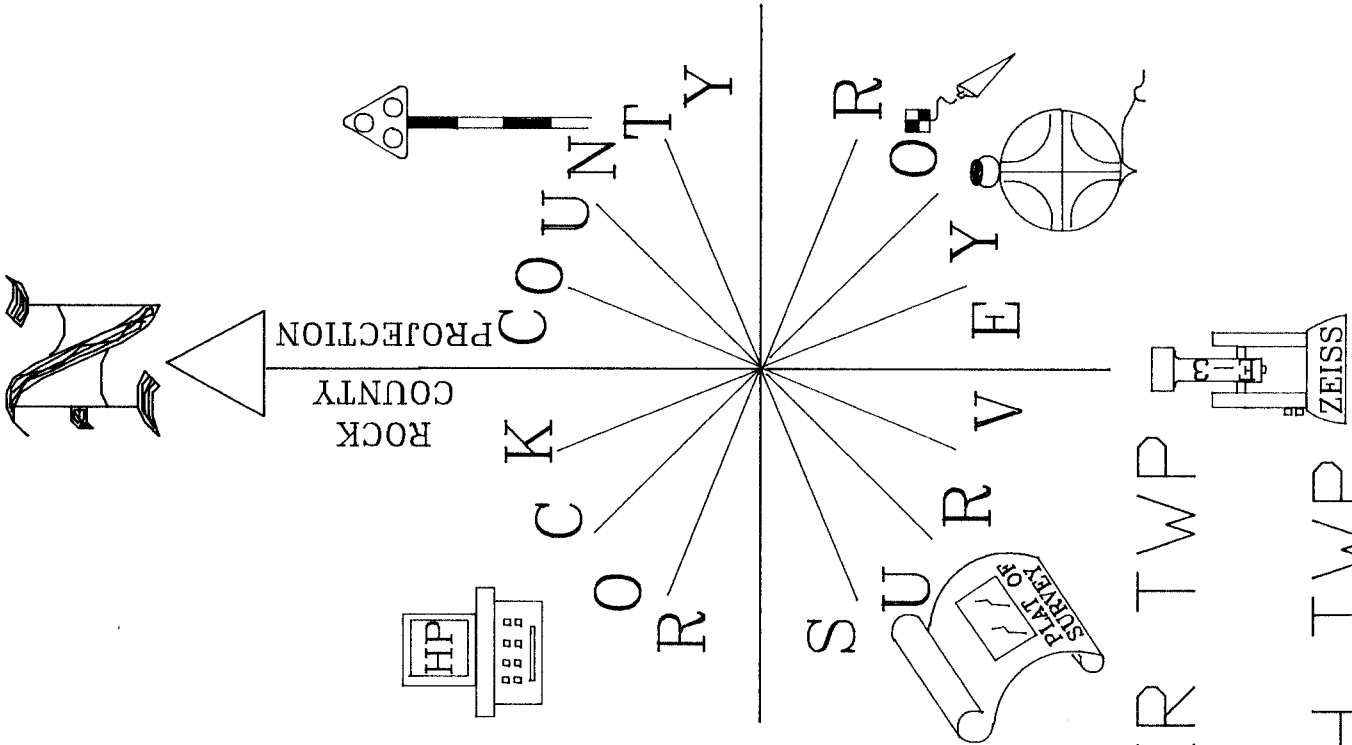

X-25