


PUBLIC LAND SURVEY MONUMENT RECORD

For Public Land Survey Corners in the  
 T. 3 N., R. 10 E  
 CORNER CODE INDEX

1	2	3	4	5	6	7	8	9	10	11	12	13	14	15	16	17	18	19	20	21	22	23	24	25
A	6	5	4	3	2																			
B																								
C	7	8	9	10	11	12																		
D																								
E	16	17	18	15	14	13																		
F																								
G	19	20	21	22	23	24																		
H																								
I	25	29	28	27	26	25																		
J																								
K	31	32	33	34	35	36																		
L																								

PLACE MONUMENT SYMBOL (◈) AT PROPER LOCATION ON ABOVE INDEX

EXAMPLE

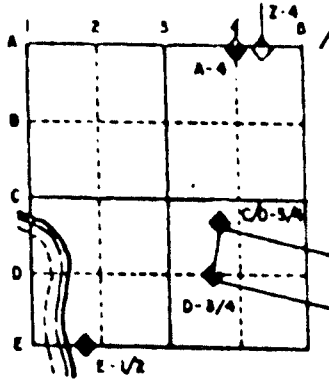

MAGNOLIA TWP  
 ROCK COUNTY WI

IF AVAILABLE  
 STATE PLANE COORDINATES

North (Y) \_\_\_\_\_ Eleve. (Z) \_\_\_\_\_  
 East (X) \_\_\_\_\_ Zone \_\_\_\_\_  
 Hor. Datum \_\_\_\_\_ Vert. Datum \_\_\_\_\_

◈ CORNER MONUMENT

○ WITNESS MONUMENT

BEARINGS ARE BASED ON:

(B) Describe any record evidence, monument evidence, occupational evidence, testimonial evidence or any other material evidence you considered, and whether the monument was found or placed.

1833 SEP 11th ORIGINAL SURVEYOR FIELD NOTES. NORTH ON EAST SIDE OF SECTION 1. SET QUARTER SECTION POST IN PRAIRE AND MADE A MOUND OF EARTH & SOD 2 1/2 FEET HIGH & S 1/2 FEET DIAMETER AT THE BASE. 2640 TO TEMPY 6 MILE POST.

1833 SEP 15th ORIGINAL SURVEYOR FIELD NOTES. WEST ON SOUTH LINE SECTION 31 PORTER TWP 7756.32' INTERSECTED RANGE LINE 118.8' SOUTH OF TEMPORARY POST. SET POST AT INTERSECTION CORNERS TOWNSHIPS 3 & 4 N RANGES 10 & 11 E AND MADE A MOUND 4 FEET SQUARE AT BASE AND 4 FEET HIGH.

1835 US PLAT MAP CALLS FOR 2560.8 TO NE CORNER OF SECTION 1. BASED ON RUGER AND CHURCH'S MEASUREMENTS THIS IS PROBABLY AN ERROR. SHOULD BE 2521.2' (2640 - 118.8').

1855 CHURCH 1855 VOL 1 PG 47 DID NOT STATE WHAT HE FOUND OR PLACED. CALLS FOR 2626.80 TO SE, 2529.12' TO NE & 2647.92' TO CENTER CORNERS OF SECTION 6.

DUG SMALL HOLE AND FOUND NOTHING.

C) Was the corner restored through acceptance of (1) an obliterated evidence location, or, (2) a found perpetuated location?

NO

D) Describe any material discrepancy between the location of the corner as restored or reestablished and the location of that corner as previously restored or reestablished by distance and direction. Show the discrepancy on the plan view drawing under (a), above. Show the distances between the corner as previously restored or reestablished and (1) the corner as restored or reestablished, and (2) to at least 4 of the witness monuments shown on the drawing in (a), above.

(E) Was the corner reestablished through lost corner proportionate methods? If so, show the method, including the directions and distances to other public land survey corners used as evidence or used for proportioning the corner location.

YES. CORNER PLACED ON LINE WITH THE W 1/4 CORNER OF SECTION 6 AND SW CORNER OF SECTION 6 CENTER TOWNSHIP AT RECORD ORIGINAL GOVERNMENT DISTANCE.

I, Donald Barnes, hereby certify that the corner points as identified by the corner code index were, in a field survey on, Sep 16, 1994, established, re-established, monumented, re-monumented, recovered or restored as expressed below and in conformance with the regulations and rules as required in the current manual of survey instructions of the United States Department of Interior, Bureau of Land Management.

seal

*Donald Barnes*  
Sep 20, 1994

EMBOSS LAND SURVEYOR SEAL

COUNTY SURVEYOR FILING DATA

Date of computer entry \_\_\_\_\_

Date microfilmed \_\_\_\_\_

Number of included sheets \_\_\_\_\_  
CORNER CODE

10F3 C 25



# PLAT AND RECORD

Survey on Section 36  
 Township 10 N. Range 10 E. of the 4 P. M. in  
 CENTER UNION MAGNOLIA  
 County, Wisconsin, made  
 SEPTEMBER 19th 1994

I hereby certify that the following is a correct record of said survey as made by me.

County Surveyor.

SO-14-48E 2658.85  
 BARNES 1980 2658.81  
 1325 BARNES 1979 1330

NO-35-09E 2276.86  
 BARNES 1980 2276.85  
 ORIG 2254.56

SO-11-04E 2655.13  
 RUGER 1870 2653.2 VAR 8-45  
 BARNES 1980 2654.94  
 ORIG 2640

NO-0456E 2650.48  
 RUGER 1870 2652.54 VAR 6-58  
 BARNES 1980 2650.47  
 ORIG 2640

LOCKE PRO 2618.27  
 S89-47-28E 2618.51  
 LOCKE 1867 2612.29 VAR 7-00  
 RUGER 1870 2619.54 VAR 6-39  
 BARNES 1980 2619.50  
 ORIG 2602.05

LOCKE PRO 2652.66  
 NO-12-30W 2652.27  
 LOCKE 1867 2646.50 VAR 7-35  
 LOCKE PRO 2654.24  
 SO-12-30E 2661.50  
 LOCKE 1867 2646.19 VAR 7-36

LOCKE PRO 2626.99  
 S89-36-51E 2626.51  
 BARNES 1980 2626.51  
 RUGER 1870 2626.8 VAR 6-38  
 LOCKE 1867 2620.99 VAR 6-55

INT 1/4 LINES 2648.43  
 NO-20-20W 2648.94

CHURCH 1855 2651.88  
 BARNES 1980 2657.12  
 ORIG 2635.38  
 BARNES 1980 2657.13  
 ORIG 2635.38  
 586-52-22E 2656.75


LOCKE PRO 2618.27  
 S89-46-10E 2618.53  
 LOCKE 1867 2612.29 VAR 7-00  
 RUGER 1870 2619.54 VAR 6-39  
 BARNES 1980 2618.53  
 ORIG 2602.05

LOCKE PRO 2611.32  
 S89-45-10E 2616.48  
 LOCKE 1867 2605.36 VAR 7-00

LOCKE PRO 2656.63  
 SO-28-25E 2656.84  
 LOCKE 1867 2650.56 VAR 7-55  
 RUGER 1870 2652.54 VAR 7-28

CHURCH 1855 2491.50  
 ORIG PLAT 0  
 ORIG FIELD NOTES 0  
 NO-27-12W 2562.24  
 ORIG FIELD NOTES 2640 TO TEMP. POST  
 CHURCH 1855 2529.12  
 ORIG PLAT 1240.8  
 1320 ORIGINAL SHOULD BE 2521.2 (2640-118.8)

CHURCH 1855 2647.92 VAR 4  
 S86-39-16E 2653.11  
 INT 1/4 LINES 2643.02  
 CHURCH 1855 2626.80  
 ORIG PLAT 2640  
 NO-25-53W 2639.03  
 CHURCH 1855 1313.4  
 1313.4 CHURCH 1855 1313.4

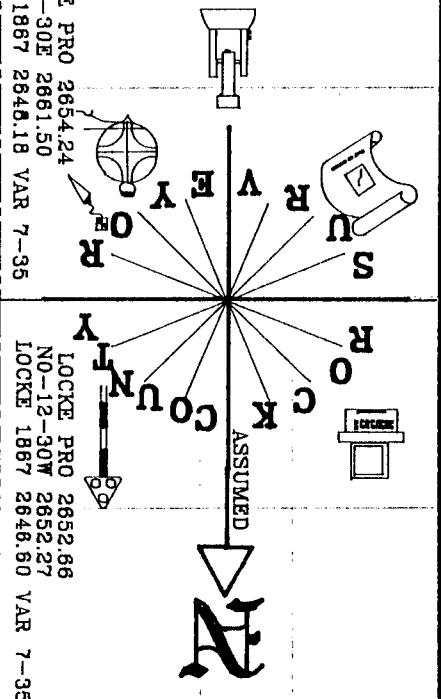

COMPUTED PER M LAYS  
 ON LINE WITH 1/4 CORNERS  
 & AT EQUAL DISTANCE

SEC 1

SEC 36

SEC 6

SEC 31

3 OF 3

Handwritten signature and date: *James Brown*  
 Sep 20, 1994

FD ALUM. BARNES 1980 2657.12  
 ORIG 2635.38  
 BARNES 1980 2657.13  
 ORIG 2635.38  
 586-52-22E 2656.75

FD ALUM. BARNES 1980 2657.12  
 ORIG 2635.38  
 BARNES 1980 2657.13  
 ORIG 2635.38  
 586-52-22E 2656.75

