
PUBLIC LAND U.S. SURVEY MONUMENT RECORD

For Public Land Survey Corners in: T.3 N., R. 14 E

WI ADMINISTRATIVE CODE A-E 7.08 REQUIREMENT

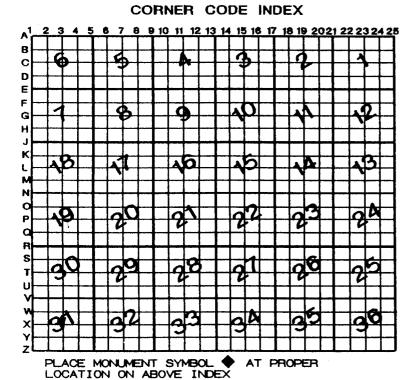

JOHNSTOWN TWP ROCK COUNTY WI

IF AVAILABLE ROCK COUNTY COORDINATES PERFERRED

North	Elev
East	·
Hor. Datum	Vert, Datum
LATITUDE	ELLIPS. H
LONGITUTE	
GPS (X)	TRAVERSE (X)
BASED ON THE	FOLLOWING CONTROL:

CORNER MONUMENT

WITNESS MONUMENT

ÿ BEARINGS ARE BASED

(a)

				/
FIELD BOOKPAGE #S	HEET		OF	
SHOW A PLAN VIEW DRAWING DEPICTING THE CORNER MONUMENT AND	SURRO	UNDING		
PHYSICAL FEATURES, INCLUDING THE EXCAVATION AREA AND DEPTH.				
PLANNING & ZONING COMMITTEE ADOPTED THE ABOVE FORM ON 12/2/1982				

108614

- (B)Describe any record evidence, monument evidence, occupational evidence, testimonial evidence or any other material evidence you considered, and whether the monument was found or placed.
- 1905 RUGER VOL 5 PG 321 SET LIMESTONE 13 ½ X 8 X 6 SURROUNDED BY 4 HARD HEADS. VAR 1-40 2648.58' TO W 1/4 COR SEC 31 AND 2641.98 TO E 1/4 COR SEC 31, VAR 2-34 2656.34 TO N 1/4 COR SEC 31, & 2637.36' TO S 1/4 COR SEC 31.
- 1969 BATTERMAN VOL 4 PG 404 STATES NOTHING ABOUT CORNER BUT CALLS FOR CORNER IN REFERENCE TIES.
- 1983 BARNES REMONUMENTATION PLAT. S87-58-18E 5210.28 (LOCKE 5200.97; 5290.56) FROM W 1/4 TO E 1/4 CORNERS OF SEC 31.

SEARCHED & FOUND NOTHING. ASPHALT PAVEMENT WILL GROUND AND ROAD PAVED.

- C) Was the corner restored through acceptance of (1) an obliterated evidence location, or, (2) a found perpetuated location?
- D) Describe any material discrepancy between the location of the corner as restored or reestablished and the location of that corner as previously restored or reestablished by distance and direction. Show the discrepancy on the plan view drawing under (a), above. Show the distances between the corner as previously restored or reestablished and (1) the corner as restored or reestablished, and (2) to at least 4 of the witness monuments shown on the drawing in (a), above.
- (E) Was the corner reestablished through lost corner proportionate methods? If so, show the method, including the directions and distances to other public land survey corners used as evidence or used for proportioning the corner location.
- I, Donald Barnes, hereby certify that the corner location as identified by the corner code index was determined by me under my direction and control and that this U.S. Public Land Survey Monument Record is correct and complete to the best of my knowledge and belief.

seal

Proced Barres emboss 0.776, 2000

Number of included sheets 1

CORNER CODE X-3

A-E 7.08 REQUIREMENT