

~~U.S. PUBLIC LAND SURVEY MONUMENT RECORD~~


For Public Land Survey Corners in the
T. 3 N., R. 4 E.

CORNER CODE INDEX

	1	2	3	4	5	6	7	8	9	10	11	12	13	14	15	16	17	18	19	20	21	22	23	24	25
A																									
B																									
C	6																								
D		5																							
E			4																						
F				3																					
G					2																				
H	7																								
I		8																							
J			9																						
K				10																					
L					11																				
M						12																			
N	18																								
O		17																							
P			16																						
Q				15																					
R					14																				
S						13																			
T	19																								
U		20																							
V			21																						
W				22																					
X					23																				
Y						24																			
Z							25																		
								26																	
									27																
										28															
											29														
												30													
													31												
														32											
															33										
																34									
																	35								
																		36							

PLACE MONUMENT SYMBOL (◆) AT PROPER LOCATION ON ABOVE INDEX

EXAMPLE

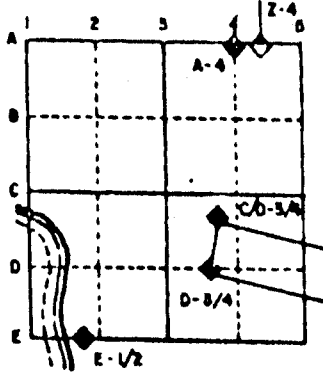

JOHNSTOWN TWP
ROCK COUNTY WI

IF AVAILABLE
STATE PLANE COORDINATES

North (Y) _____ Eleve. (Z) _____
 East (X) _____ Zone _____
 Hor. Datum _____ Vert. Datum _____

◆ CORNER MONUMENT

○ WITNESS MONUMENT


BEARINGS ARE BASED ON:

MICROFILMED


SHEET _____ OF _____

CORNER CODE: P 21


N 1/4 COR
SEC 23

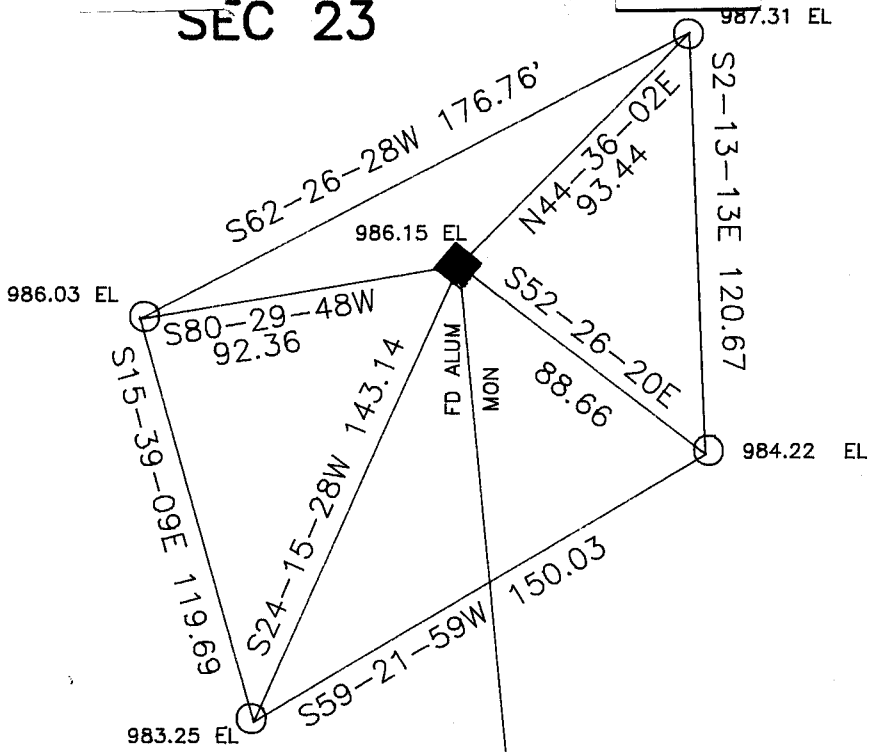

TWP PROJECT 2638.07
COMBS 2638.02
S1-02-48E 2638.07

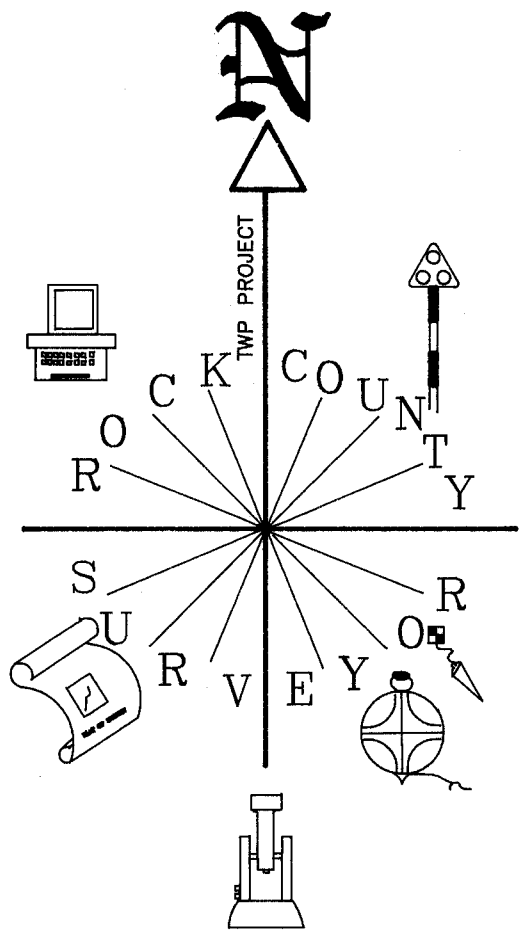

FB #2 PG 34
○ 3/4 X 24 REROD 15"
DEEP WITH MAGNET

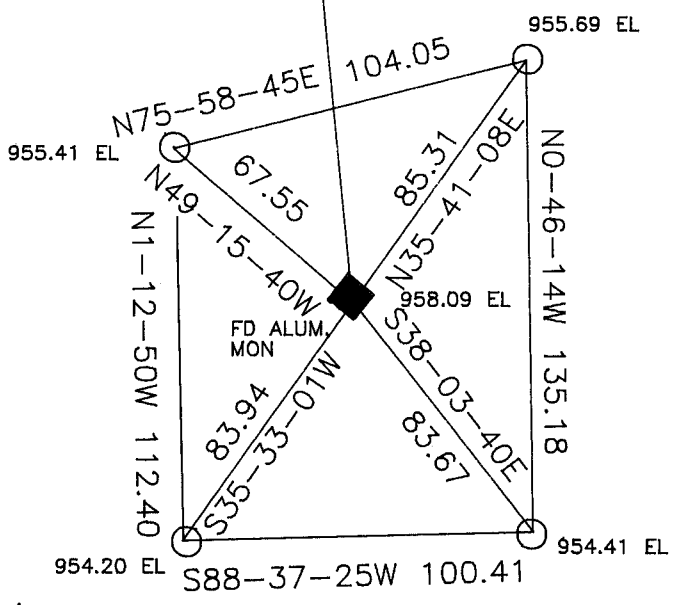

E 1/4
SEC 23

Donald Buines
Dec 1, 1993

ROAD BEING CONSTRUCTED
ALONG SECTION LINE