
U.S.

LAND **PUBLIC** SURVEY MONUMENT RECORD

For Public Land Survey Corners in: T. 3 N., R. 14 E

WI ADMINISTRATIVE CODE A-E 7.08 REQUIREMENT

CORNER CODE INDEX

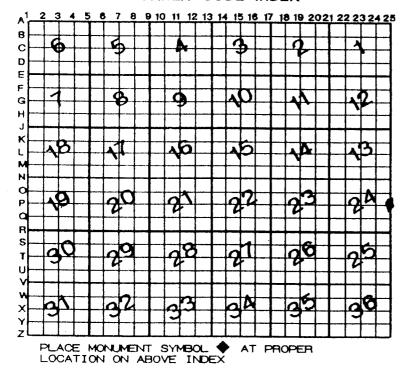

JOHN	STOWN	<u>J</u>	TW	P
ROCK	COUNTY	W	I	

IF AVAILABLE ROCK COUNTY COORDINATES PERFERRED

North 258, 9/6.69 Elev. East 2,328, 589, 35

Hor. Datum /927 Vert. Datum

LATITUDE

_ELLIPS. HT.

LONGITUTE

GPS (X) _

TRAVERSE (X)

BASED ON THE FOLLOWING CONTROL:

◆CORNER MONUMENT

WITNESS MONUMENT

(a)

A LETTER WAS SENT ON JULY 23, 2003 WITH THE FOLLOWING LANGUAGE. SINCE HE HASN'T RESUBMITTED ON THE CORRECT FORMS, HIS U.S. PUBLIC LAND SURVEY MONUMENT RECORD IS FILED AS: MAP # 14772 IN SEC 24 T 3 N R14 E. PLAT OF SURVEY RECORDS. DONALD BARNES, COUNTY SURVEYOR.

Dear Mr. Kreblin,

Thank you for the copies. In order to file them with the U.S. Public Land Survey Monument Records they need to be on the County's adopted form. I am sending you several blank forms to complete if you wish to file them with the U.S. Public Land Survey Monument Records. If not, I will file them with the plat of surveys.

BEAFINGS ARE

Ö

2/17/2009 Omold Barnes

SHEET .

SHOW A PLAN VIEW DRAWING DEPICTING THE CORNER MONUMENT AND SURROUNDING PHYSICAL FEATURES, INCLUDING THE EXCAVATION AREA AND DEPTH.

PLANNING & ZONING COMMITTEE ADOPTED THE ABOVE FORM ON 12/2/1982

CORNER CODE <u>P25</u>